

T255  
R4W

U.S. CADASTRAL SURVEY  
BUREAU OF LAND MANAGEMENT  
1957  
W 1/16 S 20  
S 29

DATE: 10-3-78

Condition Report Only  
 Not Found  
 Renewed  
 Unrecorded  
 Surveyed In  
 Referenced Out

Previous Renewal #'s 1957 RESURVEY ONLY

Monument(s) Found: (Condition and Source) AN U.S. BLM CADASTRAL SURVEY BRASS CAP ON A 2 IN. PIPE, 1 IN. ABOVE GROUND, MARKED " W 1/16 S 20 " S 29 1957

Accessories Found: (Condition and Source) A 32 IN. FIR SNAG, BEARS N. 44 1/2° W., 28.8 FT. DIST. (REC. 29.04 FT. DIST.) WITH WELL HEALED SINGLE BLAZE. BLAZE PITCHED OVER.

A 23 IN. FIR STUMP BEARS S 22 1/2° W., 69.9 FT. DIST. (CUT LOW. NO SCRIBING VISIBLE.)

NOTE: MON. AND ACCESS. AS PER 1957 RESURVEY

#129 ✓

RENEWAL

Monument Set: (Procedure and Description) LEFT CAP IN  
POSITION.

New Accessories: (Description)

A 12 IN. D. FIR, BEAR S. 39° E., 47.65 FT. DIST.  
SCRIBED "W'16 S 29 CS BT" IN DOUBLE BLAZE.

A 9 IN. INCENSE CEDAR, BEARS N. 7½° E., 25.6 FT. DIST.  
SCRIBED "W'16 S 20 CS BT" IN A DOUBLE BLAZE.

Location and Comments:	<u>20° EAST</u>	Compass Declination
	<u>DCSO</u>	Agency
	<u>KAREN REED</u>	Party Chief
	<u>KAREN REED</u>	Notekeeper
	<u>STEPHEN J. FLAHE</u>	Witnesses

OK  
*[Signature]*


Section 70 Twp 25 S Rge 4 W

Date: 6-9-75

How was corner identified? B.C. & 1 BT

Condition of corner: good

Best route to reach corner: \_\_\_\_\_

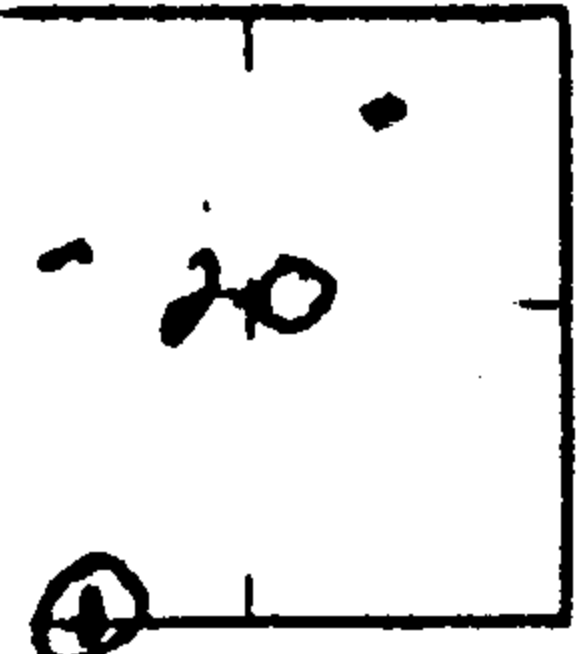

3756  
12309

TAKE P.P. 21  
FOR BLM  
OR BLM  
25-4-82

Other Remarks:

Quadrant	NE	NW	SE	SW
Species & Size		28" D		
Dist. & Bearing		S 44 1/2 E, 44 kS		
Condition of Scribe				
Original or Resurvey				
Appearance of B.T.		good		
Tags, Marks, etc.		BT tag		

W. Steven Cole  
Forester, Woolly Mt.  
Signed

C. S. File No. 60/17-11