


T315 R2W

DATE: 10/19/78

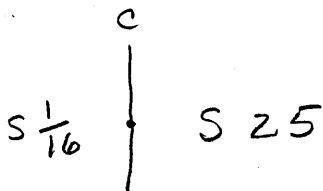

- Condition Report Only
- Not Found
- Renewed
- Unrecorded
- Surveyed In
- Referenced Out

PE 2128

Previous Renewal #'s (M 42-77)

Monument(s) Found: (Condition and Source) FOUND 3" BRASS
 CAP ON A 2" IRON PIPE OUT OF PLACE,
 TORE LOOSE BY AN UPROOTED TREE.
 BRASS CAP STAMPED AS SHOWN
 ABOVE.

Accessories Found: (Condition and Source) A 17" CEDAR
 BEARS N 42° E, 35.1 ft., S CRIBING
 VISIBLE ON A DOUBLE BLAZE, "CS 1/16
 PE 2128 BT" A 21" DOUG FIR
 BEARS S 36° W, 35.8 ft. FACES
 ARE PITCHED OVER.

RENEWAL

Monument Set: (Procedure and Description) I RESET
THE FOUND BRASS CAP & IRON PIPE
BY REFERENCE TO BEARING TREES.

New Accessories: (Description) NONE

Location and Comments: 20°E Compass Declination
U.S.F.S. Agency
CORNER LIES DENNIS L. GAYLORD Party Chief
75' EAST OF " " Notekeeper
F.S. ROAD No. LORI COLE Witnesses

OK
[Signature]