

DATE: 10-31-78

T 27 S R 5 W

S W COR

DLC 40

IN SECTION 19


Condition Report Only
 Not Found
 Renewed
 Unrecorded
 Surveyed In
 Referenced Out

Previous Renewal #'s 82
87 (M 8-62)

Monument(s) Found: (Condition and Source) ORIGINAL POST WITH

RAISED MOUND AND TRENCH NOT FOUND. FOUND BRASS CAP MONUMENT (PER

RENEWAL ⁸²~~87~~) MARKED AS TRACED.

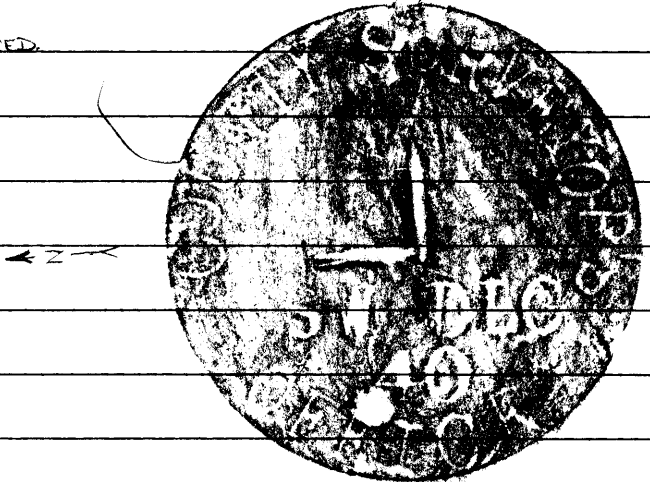

Accessories Found: (Condition and Source) ORIGINAL B. OAK NOT FOUND.

FOUND BEARING TREES PER RENEWAL ⁸²~~87~~.

1) A B. OAK 24 NOW 36 INCHES DIAMETER BEARS S 56 1/4° W 13° FEET.

TREE HAS WELL HEALED SINGLE BLAZE.

2) A B. OAK 18 NOW 24 INCHES DIAMETER BEARS S 66 1/4° E 15° FEET

TO CENTER OF BASE, 16 1/2 FEET TO CENTER OF TRUNK (REC. DIST. 16 1/2 FEET).

TREE HAS WELL HEALED SINGLE BLAZE.

#152 ✓

SHEET Page 1 of 1
 C.S. File No. 60/17-19

C

RENEWAL

Monument Set: (Procedure and Description) NONE

New Accessories: (Description) TAGGED FOUND BEARING TREES

Location and Comments:	<u>20° EAST</u>	Compass Declination
	<u>DOUG. CO. SURV. OFF</u>	Agency
	<u>LARRY E. MONROE</u>	Party Chief
	<u>Larry E. Monroe</u>	Notekeeper
	<u>PETE EARLE</u>	Witnesses

