

TR95 R7W

S 1/4 S14 ONLY

DATE: 2-14-79

Condition Report Only
 Not Found
 Renewed
 Unrecorded
 Surveyed In
 Referenced Out

Previous Renewal #'s 122

Monument(s) Found: (Condition and Source) A G.L.O. BRASS CAP

MARKED "1/4 S14" PROTRUDING 8 INS. ABOVE
1924

GROUND. (AS PER 1924 SURVEY)

Accessories Found: (Condition and Source) AN 8 IN. DIAM. D. FIR

(NOW 16 IN.) BEARS N. 60° E., 44.9 FT. DIST.

WITH WELL HEALED BLAZE. (1924 SURVEY) THE NW

BT IS GONE (1924 SURVEY) A 12 IN. DIAM. R.

FIR, (NOW 15 IN.) BEARS N. 75° W., 20.6 FT. WITH

WELL HEALED DOUBLE BLAZE. (REN 122) AN UNRECORDED

ED 12 IN. DIAM. CEDAR BEARS S. 68° W., 14.6 FT.

#260 ✗

Page 1 of 1
G. & E. No. 60/24-10

C

MARKED WITH 9 IN. "X" AND T 9 IN. LONG

BLAZES ON NORTH AND SOUTH SIDE OF TREE.

RENEWAL

Monument Set: (Procedure and Description) NONE

New Accessories: (Description) NONE

Location and Comments:

19° EAST

Compass Declination

DCSO

Agency

KAREN REED

Party Chief

Karen Reed

Notekeeper

FRANK G. SILAGY

Witnesses


OK
ghl

LOCAL RECORD
CORNERS OF THE CADASTRAL SURVEY GRID

UNITED STATES
DEPARTMENT OF THE INTERIOR
BUREAU OF LAND MANAGEMENT

T. 29 R. 7, WM Mer., OR State.

260
122
60/24

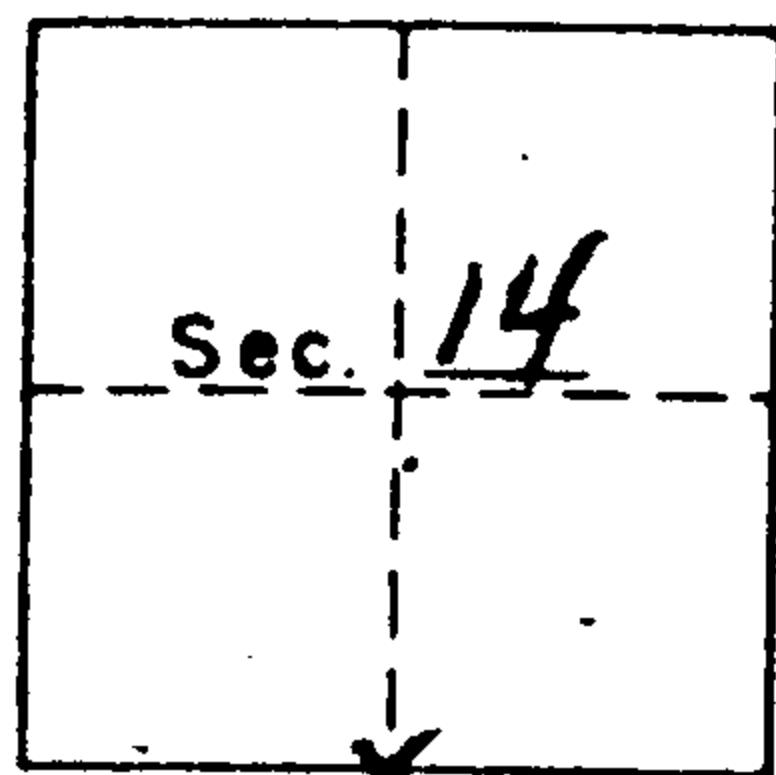

SYMBOLS

- ◆ Official corner found
- ◊ Probable corner found, authenticity doubtful.
- Corner searched for and not found.

Reported By Jesse McCaffrey
Signature

Title Forester

Date 11-12-76

MARKS: Bross COP

4 Corner common to Secs. 14, _____, _____ & _____ is a mound of stone, tree, rock, fire pit, iron pipe, _____ size _____

LEGIBLE MARKS ON BEARING OBJECTS

KIND	<u>DF</u>		
SIZE	<u>16"</u>		
BEARING			
DISTANCE	<u>62 LINKS</u>		
BT TAG POSTED	<u>yes</u>		

ADDITIONAL INFORMATION

USGL

INTERIOR--BOONEVILLE POWER ADMINISTRATION, PORTLAND, OREGON (OVER)

these cors. without success and has made a reestablishment of the cor. of secs. 1, 2, 11, and 12, by double proportionate measurement bet. the Ford cor. of secs. 1, 2, 35, and 36, on the N. bdy. of the Tp., and the Campbell cor. of secs. 13, 14, 23, and 24, and bet. the original cor. of secs. 2, 3, 10, and 11, and original cor. of secs. 1, 6, 7, and 12, on the E. bdy. of the Tp.

I also retrace Campbell's line bet. secs. 13 and 24, and practically agree with his record bearing and distance.

U.S. File No. 60/24-10