

T 255 RBW

DATE: 4-9-79

10 | 11
1/4

Condition Report Only
 Not Found
 Renewed
 Unrecorded
 Surveyed In
 Referenced Out

Previous Renewal #'s 37, ORIG. SURVEY IN 1881, AND RETRACEMENT IN 1911.

Monument(s) Found: (Condition and Source) A 1" IRON PIPE, ESTABLISHED BY V. RAY TRACY, DOUGLAS CO. SURVEYOR'S OFFICE IN 1967, (REN. #37), WITH BRASS CAP MARKED AS DESCRIBED, AND TRACY'S BT'S AS FOLLOWS:

AN 18" NOW 20" D. FIR, ALIVE AND IN GOOD CONDITION BEARS

S 31° W 4⁶ FT., AND

A 12" NOW 12" D. FIR, ALIVE AND IN GOOD CONDITION WITH WELL

HEALED DOUBLE BLAZE BEARS N 44° E 2⁶ FT.

AT THIS TIME, THE BUREAU OF LAND MANAGEMENT, ROSEBURG DISTRICT IS CONDUCTING A SURVEY WHICH UTILIZES THIS

Accessories Found: (~~Condition and Source~~) CORNER. AFTER

CONSIDERABLE DISCUSSION AND INVESTIGATION AT THE CORNER LOCATION, WE DETERMINE THAT THE CORNER SHOULD BE MORE CORRECTLY LOCATED AT RECORD BEARING AND HORIZONTAL

DISTANCE FROM THE ORIGINAL SOUTHEAST BEARING TREE WHICH WAS IDENTIFIED AND DESCRIBED BY TRACY IN 1967. THIS O.B.T. IS IN SUBSTANTIALLY THE SAME CONDITION NOW AS WHEN

#104 ✓

Page 1 of 2
S. File No. 60/24-24 U

RECOVERED
LOCATED IN 1967. WE BASE OUR DETERMINATION ON THE

FOLLOWING REASONS:

① IN HIS USE OF TOPOGRAPHIC CALLS, TRACY DOES NOT USE THE CREEK CALL (RECORD 2.60 CHAINS SOUTH OF THE $\frac{1}{4}$ CORNER). BOTH TRACY'S CORNER POSITION AND THE RECORD CORNER POSITION AS BASED ON THE ORIGINAL SE BEARING TREE ARE ~~TOO FAR EXCEED~~


RENEWAL

~~Monument Set: (Procedure and Description)~~ THE RECORD DISTANCE NORTH OF THE CREEK. ② THE CORNER LOCALITY WAS SEVERELY BURNED PRIOR TO THE 1911 RETRACEMENT, EVIDENCED BY THE FACT THAT THE 1911 BT'S WE NOTED AS "BURNT FIR". THE ORIGINAL SE BEARING TREE AND THE REMAINS OF THE ORIGINAL SW BEARING TREE,

~~New Accessories: (Description)~~ ALSO IDENTIFIED BY TRACY SHOW NO SIGNS OF HEALING OVER THE BLAZE. WE FIND NO MATURE TIMBER FOR AT LEAST 300 FT. SOUTH OF THE CORNER AND NONE FOR NEARLY THE ENTIRE HALF MILE NORTH OF THE CORNER. WE FIND NO EVIDENCE OF A BLAZED LINE. ③ THE CORNER LOCATION IS ON A STEEP SE SLOPE WITH A THIN COVER OF

Location and Comments:

Compass Declination
Agency
Party Chief
Notekeeper
Witnesses

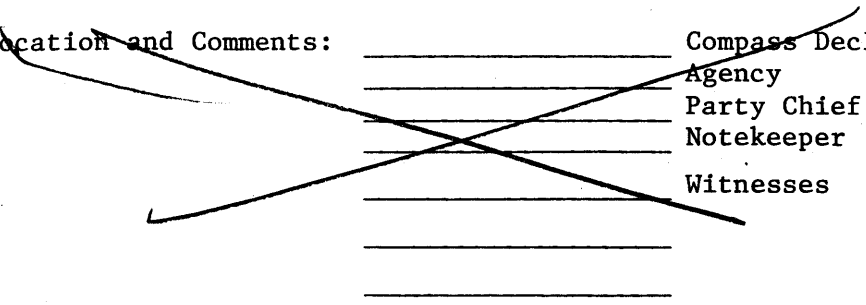

T 255 R 8W

DATE: 4-9-79

10 | 11

1/4

(CONTINUED FROM PAGE 1)

Condition Report Only
 Not Found
 Renewed
 Unrecorded
 Surveyed In
 Referenced Out

Previous Renewal #1

Monument(s) Found: ~~(Condition and Source)~~ ROCKY SOIL OVER
 BEDROCK. WE CANNOT DETERMINE THE EXTENT OR AMOUNT OF
 SLIDE ACTIVITY IN THIS AREA.

AT THIS TIME, WE WITNESS THE SETTING OF A NEW
 CORNER MONUMENT AT A LOCATION FROM WHICH THE ORIGINAL

SE BEARING TREE, PREVIOUSLY NOTED, BEARS S 47° E
 101° FT. (RECORD MEASUREMENTS S 47° E 101° FT.). THE NEW
 MONUMENT IS A 2 1/2" GALVANIZED IRON PIPE SET FLUSH IN THE
 GROUND AND LEANING EASTERLY, WITH BRASS CAP ATTACHED,

Accessories Found: ~~(Condition and Source)~~ MARKED:

U. S. DEPARTMENT OF THE INTERIOR

BUREAU OF LAND MANAGEMENT

T 255 R 8W

1/4

S 10 | S 11

1979

FROM WHICH NEW BEARING TREES WERE MARKED, page 2 of 2
 AS FOLLOWS:

G.S. File No. 60/29-21

A 10" D. Fir, scribed "1/4 S 10 BT" ON A SINGLE BLAZE BEARS
S 69° W 9⁶ FT.,

AND A 15" D. Fir, scribed "1/4 S 11 BT" ON A SINGLE BLAZE
BEARS N 83 1/4° E 4° FT.

RENEWAL

~~Monument Set: (Procedure and Description)~~ WE OBLITERATE THE
1967 DOUGLAS COUNTY SURVEYOR'S OFFICE MONUMENT AND
ACCESSORIES AS FOLLOWS: WE LEAVE THE MONUMENT IN
PLACE AND DEFACE THE MARKINGS "T25 S 28 W 1/4 50/S 11".
WE COMPLETELY REMOVE THE SCRIBING FROM BOTH

~~New Accessories: (Description)~~ OF THE 1967 BEARING
TREES.

FROM THE BLM BRASS CAP, THE 1967 DOUGLAS
CO. SURVEYOR'S OFFICE MONUMENT BEARS S 44° E 18¹ FT.

Location and Comments: 20° EAST Compass Declination
DOUGLAS Co. Surveyor's Agency
GARY L. LANGLITZ Party Chief
Gary L. Langlitz Notekeeper
FRANK C. SILAGY Witnesses
WAYNE ROGERS, BLM

OK
JAL