


CERTIFIED RECORD OF LAND CORNER MONUMENTATION

History of original corner establishment: Corner established in 1928 by Ganong & Collins: Set a 2" x 36" iron pipe 27" into ground with brass cap marked:

From which:
 A 16" fir bears S63°E, 55 lks (36.3 ft)
 A 18" fir bears S26°30'W, 45 lks (29.7 ft)

T24S R1E
 S35
 S2 | S1
 T25S R1E
 C C
 1928

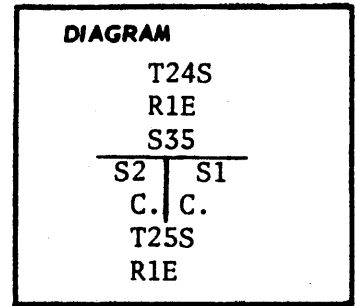

FILED
 RECEIVED

on line

MAY 9 1979

COUNTY SURVEYOR
 CLATSOP COUNTY, ORE.

Description of corner evidence found:

2" iron pipe firmly set & protruding 14" above ground.
 A 2-1/2" brass cap attached to the pipe is marked:

From which:
 A 37" Douglas-fir bear S63°E, 36.3 ft & has
 A single healed blaze,
 A 28" Douglas-fir bears S26°30'W, 29.7 ft. &
 has a single healed blaze.

U.S.G.L.O. Survey

R1E
 T24S
 S35
 C C
 S2 | S1
 T25S
 R1E
 1928

Description of monument and accessories I established to perpetuate the original location of this corner

U.S.F.S. Bearing Tree signs were placed on both B.T.'s, and they were painted with a band of red paint.
 No new accessories.

Compass Declination: 17°E

I hereby certify the above corner monument was found to be in the condition as hereon described on April 19, 1979.

Witness: Bill West

The corner $\frac{S35}{S1} | \frac{S36}{S1}$ bears N89°30'E, 57.3 ft., Record: N89°02'E, 0.86 chains (56.76 ft.)

Corner lies 50 feet north of F.S. Road 2512.

REGISTERED
 PROFESSIONAL
 LAND SURVEYOR
Dennis L. Gaylord
 OREGON
 JULY 14 1973
 DENNIS L. GAYLORD
 1636

Office of County Surveyor County of Lane DOUGLAS.
 State of Oregon , I hereby certify that the within instrument was filed in this office
 for record on the 9 day of May 19 79, at 8 o'clock a.m., (signed)
Francis L. Ingram by Virginia A. Hanger
 (COUNTY OFFICIAL) (DEPUTY)

#4 T24-1E X
#40 T25-1E X