


CERTIFIED RECORD OF LAND CORNER MONUMENTATION

History of original corner establishment:

Originally established by Alonzo Gesner in 1896 as a corner common to Sections 35 and 2:

Set a basalt stone 20" x 10" x 4", 15" into ground marked "1/4" on north side, from which:

- A 10" fir bears S45°30'E, 4 links (2.64 ft.)
- A 7" madrone bears N33°E, 18 links (11.88 ft.)

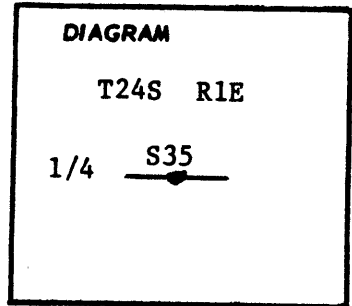

In 1928, Ganong & Collins changed this corner to refer to Section 35 only: Remark stone "1/4 S35" on north face, from which:

- Original madrone, now 12", bears N32°E, 16 links (10.56 ft.). Marks grown over.
- Original fir, now 30", bears S44°E, 45 links, not 4 links (29.70 ft.), the marks on which I destroy.
- A 10" fir bears N44°E, 42 links (27.72 ft.)

Description of corner evidence found:

Original corner stone, which measures 20" x 14" x 5", is loosely set in the ground and is broken in half. Stone is marked "1/4 35." From which:

- A 30" Douglas-fir stump bears S45°30'E, 29.7 ft., with a chopped out blaze as per 1928 record.
- A down and decayed madrone, whose stump bears N33°E, 11.88 ft. No marks visible.
- A 14" Douglas-fir stump bears N44°W (not N44°E), 25.9 ft. and 27.72 ft. slope distance. I open snag lying alongside this stump and find scribing "1/4 S35 BT."

FILED
RECEIVED

APR 25 1979

Description of monument and accessories I established to perpetuate the original location of this corner

Moving the corner stone aside, I set in its place a 1 1/2" x 36" iron pipe with a 2 1/2" brass cap attached marked:

I bury corner stone alongside. From which:

- A 26" Douglas-fir bears N54°W, 70.2 ft. scribed "1/4 S35 BT" on double blazes.
- A 19" Douglas-fir bears N24°E, 27.2 ft. scribed "1/4 S35 BT" on double blazes.

COUNTY SURVEYOR
DOUGLAS COUNTY, ORE.

T24S R1E

1/4 S35

P.L.S. 1636
1979

Compass Declination: 18°E

Corner 1/4 S2 T25S, R1E, bears west, 65.97 ft. (Record: S88°14'W, 96 links or 63.36 ft.)

U.S.F.S. bearing tree signs were placed on all B.T.'s.
Corner is about 50 ft. north of F.S. road No. 2512.



I hereby certify the above corner monument was re-established as hereon described on April 19, 1979.

Witness: Bill West

Office of..... County Surveyor..... County of..... Lane.....
State of..... OREGON.....

....., I hereby certify that the within instrument was filed in this office for record on the 25 day of APRIL, 1979, at..... o'clock A.M., (signed)

FRANCIS L. INGRAM (COUNTY OFFICIAL) by *Virginia A. Langens* (5/1/79) (DEPUTY)

38 T 25-1E X
2 724-1E X

60/24-38
C.S. File No. ~~32722~~ C