

T295 R3W

DATE: 7-16-79

56/55  
57/58

- Condition Report Only
- Not Found
- Renewed
- Unrecorded
- Surveyed In
- Referenced Out

Previous Renewal #'s NONE

Monument(s) Found: (Condition and Source) NONE

Accessories Found: (Condition and Source) A 36" FIR, ORIG.

40" DIAM BEARS S87E, 18.5 FT DIST. WITH

PARTIAL BARK SCRIBE "S" VISIBLE. AN 15"

LAUREL FOUND FALLEN AND ROTTED BEARS S. 30' W,

11.9 FT. DIST. (ORIG)

#130 X

RENEWAL

Monument Set: (Procedure and Description) A 1 X 36" I PIPE

WITH BRASS CAP MARKED " DOUGLAS COUNTY SURVEY "

7295  
56 | 55  
57 | 58  
R3W

1979

New Accessories: (Description) A 5" DIAM. FIR SCRIBED

" 7295 R5W S6 CS BT " IN DOUBLE BLAZE BEARS N. 22° W., 29.5

FT. DIST. A 17" CEDAR SCRIBED " 7295 R3W S5 CS BT " BEARS

S 46 1/2° E., 8<sup>5</sup> FT. DIST. WITH DOUBLE BLAZE. A 7" DIAM. FIR

SCRIBED " 7295 R3W S6 CS BT " IN DOUBLE BLAZE BEARS N. 75° W.,

15.7 FT. DIST. AN 8" DIAM W. FIR SCRIBED " 7295 R3W S5 CS BT "  
IN A DOUBLE BLAZE BEARS N. 87° E., 44<sup>5</sup> FT. DIST.

Location and Comments:

<u>19° EAST</u>	Compass Declination
<u>DC 50</u>	Agency
<u>KAREN REED</u>	Party Chief
<u>Karen Reed</u>	Notekeeper
<u>FRANK C SILAGY</u>	Witnesses
<u>BURT HOLT</u>	

OK  
JHL

Rm. 122 - COURTHOUSE  
ROSEBURG, OR 97470

DOUGLAS COUNTY SURVEYOR


PH. 672-3311  
EXT. 114

CORNER RENEWAL REQUEST

Section 6 Twp. 29S Rge. 3 W

Date 5-23-75

Condition of Corner and Accessories: COR GONE ONE BT LEFT  
AND IT IS ON A OLD GR. FIR BARK SCRIBED

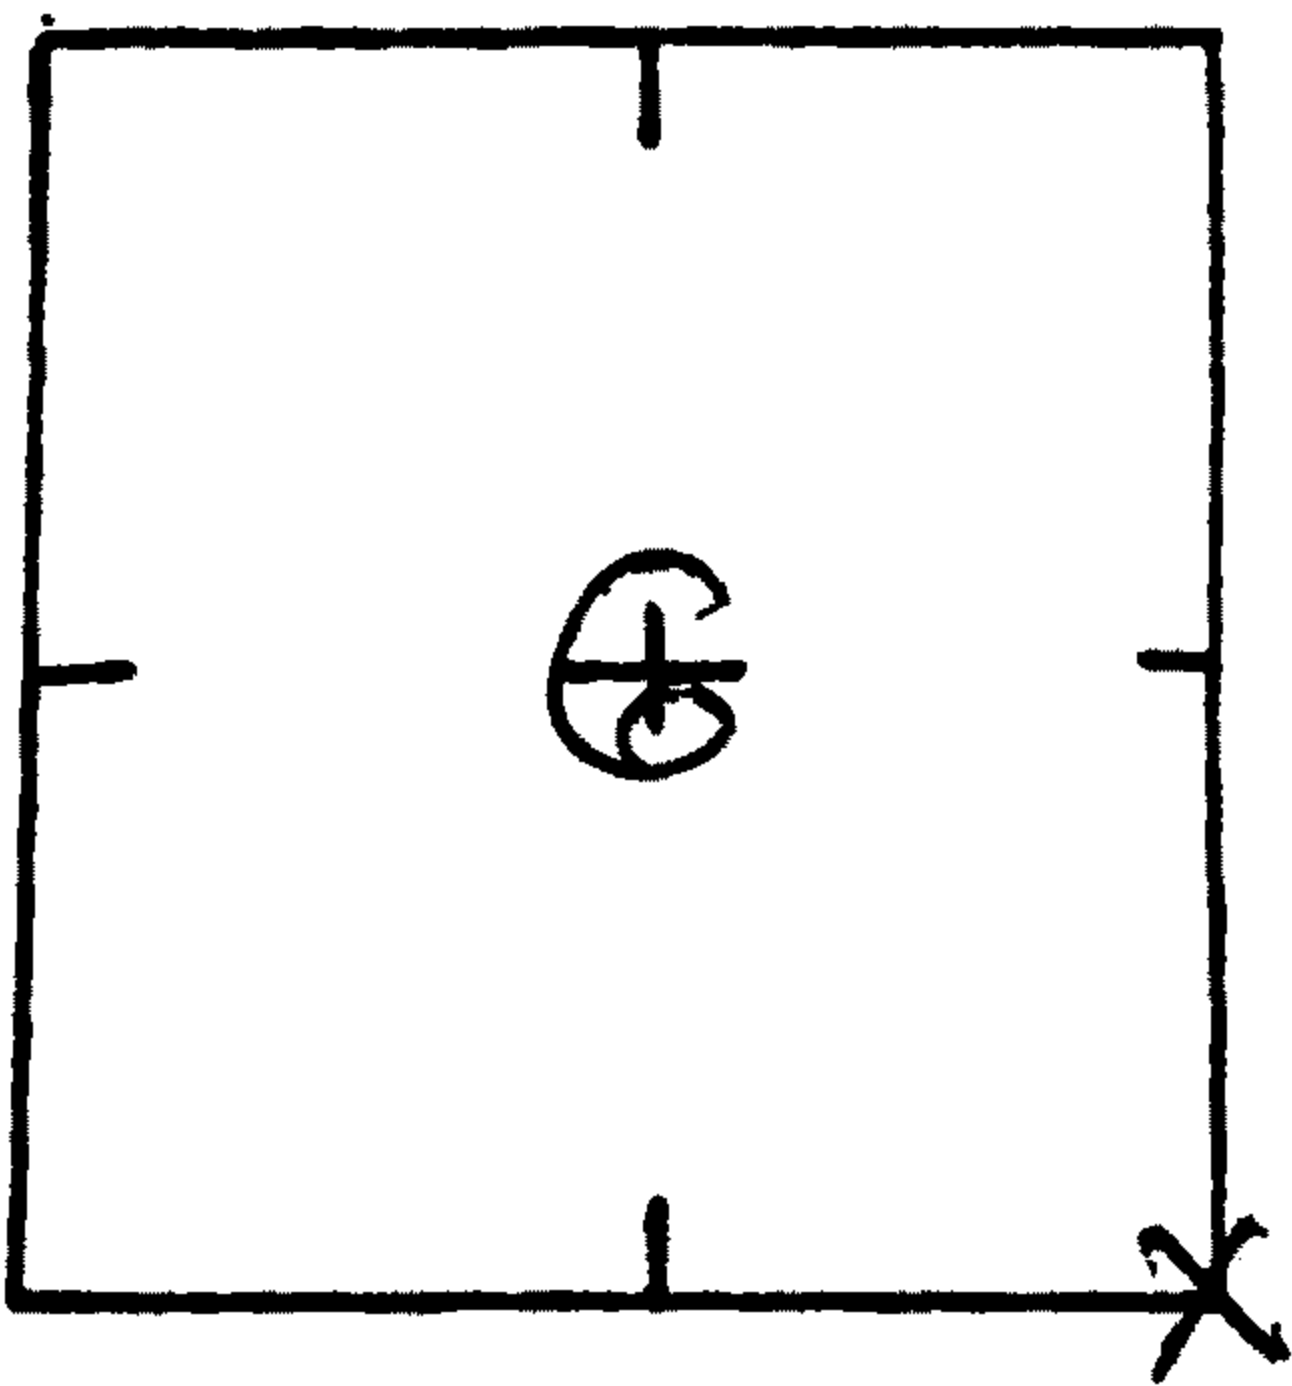

TO REACH: (Please show approximate distances, clearcuts, roads, fences, etc.) CALL ME PRIOR  
TO VISIT AND I WILL TAKE YOU THERE

Notify immediately prior to renewal visit? Yes  No

Notify following renewal visit? Yes  No

Is corner in immediate danger of being lost or disturbed? Yes  No

Name BURT HOLT

Address SUN STUDS INC

Telephone 873-1251

ADDITIONAL COMMENTS

Notes Attached

original only

5-23-75