


Corner is in T27S R1E

DATE: 8/14/79

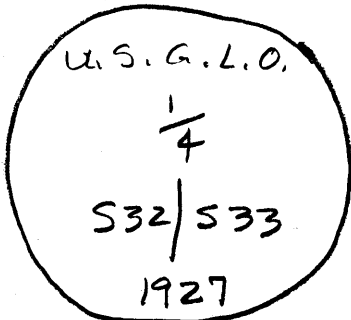

- Condition Report Only
- Not Found
- Renewed
- Unrecorded
- Surveyed In
- Referenced Out

Previous Renewal #'s _____

Monument(s) Found: (Condition and Source) 2 1/2" BRASS CAP ON A 1" IRON PIPE. BRASS CAP IS STAMPED AS SHOWN ABOVE.

Accessories Found: (Condition and Source) A 32" WHITE FIR BEARS N 75° W, 31.6 ft. SCRIBING VISIBLE ON A NEARLY HEALED & ROTTED BLAZE.

A 28" WHITE FIR BEARS N75°E, 23.1 ft. (RECORD BEARING IS N70°E)

23 ✓

RENEWAL

Monument Set: (Procedure and Description) I ADD

"T275 R1E" TO BRASS CAP.

New Accessories: (Description) A 6" WHITE FIR BEARS

N83°W, 34.6 FT. SCRIBED "1/4 S 32 CS BT"

ON DOUBLE BLAZES. A 5/8" IRON ROD

WITH A 1 1/2" ALUM. CAP, MARKED "RM"

BEARS S8°E, 21.2 FT. A 5/8" IRON ROD WITH

A 1 1/2" AL CAP, MARKED "RM" BEARS N 26°W, 36.5 FT.

Location and Comments:

CORNER IS LOCATED

IN A SALVAGE

LOGGING UNIT WHICH

WILL BE LOGGED

THIS FALL.

22°E

U.S. F.S.

DENNIS GAYLORD

" "

DARREL MYERS

Compass Declination

Agency

Party Chief

Notekeeper

Witnesses

OK jml