

opera
rel, et.
and over
d Overhead
ed Scraper, w
auger type, f
but less

Sp 238R4W

see attached
NOTE

✓ to cut bet 19-30

Set a cedar post from
N8 bearing tree, the other
bearing cut down. The marks
on N8 bearing tree were
not visible but badly de-
cayed obliterated so I marked
the old tree.

A yard 16" in diam bears N
56° W. 60 lbs. fir 20" 884 W

Witness by
Marion Bigelow
Donald "

Not on
Record -
Refer to
in Rem #19
By IRVING

✓ to cut bet 29-30 Sp 238R4W

Set a cedar post by marks
found on ~~the~~ rotten stump
of S bearing tree marked a


fir 24 N 17° W 17 cedar 10 S 52 E 24

Marion Bigelow Donald Bigelow

17/20
19/10/80

✓ 44 bet 34.35. 22 8 1/2
Del a piece of iron 18 in long
in mound of stone and marks
both all bearing fallen & decayed.
marked a wh. bet 8 & 30 N. 17 1/2 ft

" " " " 12 7 10 8 17 1/2 "
Witness Chaney Smith and A.
Thornes

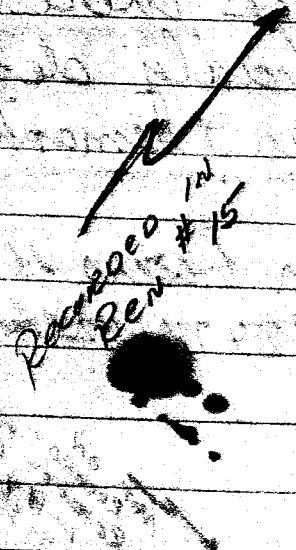

D. F. THEIK

61/5-1
C.S. File No. ~~38102~~