

DATE: 9-30-80

 Condition Report Only

 Not Found

 X Renewed

 Unrecorded

 Surveyed In

 Referenced Out

Previous Renewal #'s T27-5 T27-6
38, 116 #118-135

Monument(s) Found: (Condition and Source) A 1" X 36" IRON PIPE

'WITH BRASS CAP STAMPED "COUNTY SUCCESSIONS OFFICE"
T275

<u>SET FIRMLY IN THE GROUND</u>	<u>R</u>		<u>R</u>
	<u>6</u>	<u>S1/S6</u>	<u>S</u>
<u>PROTRUDING 0' FT ABOVE</u>	<u>W</u>	<u>S12/S7</u>	<u>W</u>
<u>GROUND. (REN 116)</u>		<u>1967</u>	

A IRON BOLT WITH A 1" SQUARE HEAD SET ALONG
THE NW SIDE OF THE CAP (REN 38) NO ORIG.

EVIDENCE FD

Accessories Found: (Condition and Source) A ²⁰~~26~~ IN. DIAM. WHITE

OAK, NOW A 26" BEARS N 46° W, 132.0 FT. WITH
WELL HEALED UPPER BLAZE AND PREVIOUSLY CHOPPED
LOWER BLAZE NOW ROTTED. A 12 IN. DIAM. WHITE

OAK NOW 20 IN. BEARS N. 40° E, ^{76.5}~~76.6~~ FT.
TO CENTER, 75.9 FT. TO FACE, (REC. 85.6 CHANGED TO
75.6 FT. REN 38) WITH WELL HEALED SINGLE BLAZE

#152 T27-5
#152 T27-6

RENEWAL

Monument Set: (Procedure and Description) LEFT BRASS

CAP AND BOLT IN PLACE AS THEY APPEARED UNDISTURBED.

New Accessories: (Description) A 5/8" x 30" IRON ROD

WITH ALUM. CAP STAMPED "B01" BEARS S. 45° E. 30° FT. BURIED 2 IN. BELOW GROUND.

A 5/8" x 30" IRON ROD WITH ALUM. CAP STAMPED "B02" BEARS S. 45° W. 30° FT. BURIED 2 IN. BELOW GROUND.


NO TREES AVAILABLE TO THE SOUTH AT A REASONABLE DIST.

Location and Comments:

COR. LIES IN OPEN FIELD APPROX. 64° FT. SOUTH OF NEWTON CRK.

19° EAST
DCSO
STEPHEN J. FLAUS DEPT.
Karen Reed Deputy
TEKESA L. BULOV

Compass Declination
Agency
Party Chief
Notekeeper
Witnesses

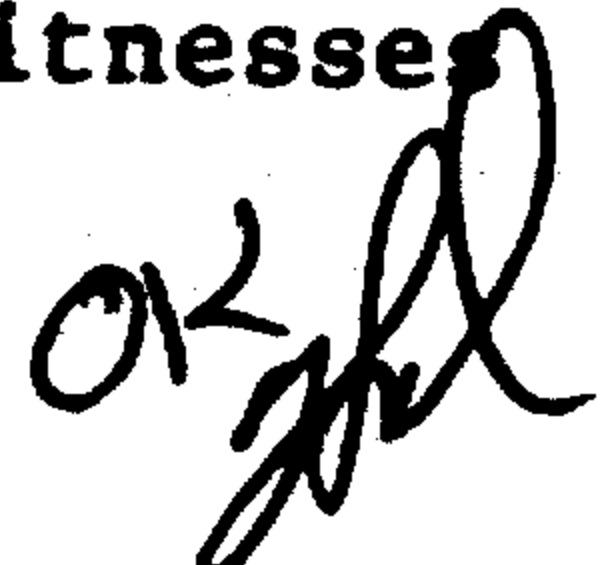

15-11-11

15-11-11
15-11-11