

DATE: 10/30/80

- Condition Report Only
- Not Found
- Renewed
- Unrecorded
- Surveyed In
- Referenced Out

Previous Renewal #'s 61

Monument(s) Found: (Condition and Source) _____

1 1/2" d, I.P. SET BY POWELL IN 1968, FIRMLY SET PROJECTING 10" ABOVE GROUND, WITH BRASS CAP MARKED AS ABOVE.

Accessories Found: (Condition and Source) ORIGINAL BT:

A) 22" d, D.FIR SNAG, S89°W, 7⁹ FT. TO FACE, WITH S.M. "BT" VISIBLE ON PREVIOUSLY OPENED BLAZE,

AND BTS MARKED BY POWELL IN 1968:

A) 24" d, D.FIR, N15 1/2° E, 26⁵ FT. WITH PARTLY HEALED BLAZE;

#203 X

A) 15" d, D. FIR, S33°E, 32³ FT (REC. 33⁴ FT.),

WITH HEALED DOUBLED BLAZE;

A) 35" d, D. FIR STUMP, S45°W, 44⁹ FT, WITH

PARTLY HEALED BLAZE;

RENEWAL

Monument Set: (Procedure and Description)

ADDED 2' d, MOUND OF STONE, I.P. NOW

PROJECTING 4".

New Accessories: (Description)

I MARK A NEW BT:

A) W. FIR, 5" d, S30¹/₄°W, 31⁴ FT., MARKED

"T.30S R1W S30 CS BT".

Location and Comments:

18°E

Compass Declination

U.S.F.S.

Agency

LEONARD HERZSTEIN

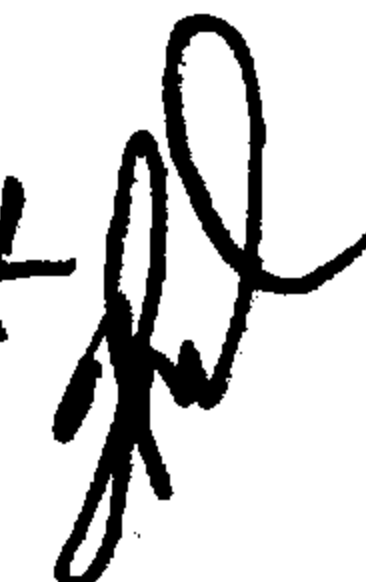
Party Chief

Notekeeper

AAT ARCINIEGA

Witnesses

JOE RICHEY

OK 

DATE: 10/30/80

T30S R1W $\frac{S19}{S30} | \frac{S20}{S29}$

- Condition Report Only
- Not Found
- Renewed
- Unrecorded
- Surveyed In
- Referenced Out

Previous Renewal #'s 61

Monument(s) Found: (Condition and Source) _____

Accessories Found: (Condition and Source) _____

A) 11" d, W. FIR, N17°W, 29³ FT (REC. D. FIR,
 N15°W, 28⁸ FT.) WITH PARTLY HEALED
 BLAZE.