

DATE: Jan 27, 1981

Condition Report Only

Not Found

Renewed

Unrecorded

Surveyed In

Referenced Out

T25S R2W

1/4 523
526

Previous Renewal #'s 1962 BLM Remonumentation by F.A. Brooks
1962 BLM Resurvey

Monument(s) Found: (Condition and Source) Because of
logging, road work and stream in area the
monument position is destroyed and after
a thorough search of the locale no evidence
of the brass cap and iron pipe, or the
original monument stone, is found.

Accessories Found: (Condition and Source) An original 12 ins.
diam. ^{hemlock} now a 30 inch diameter Hemlock stamp,
uprooted and loose from ground, lies close
to record bearing and distance from original
monument location (as determined from the
other original bearing tree.) This stamp has good
evidence of a blaze. An original 9 ins. diam. ^o
Hemlock now a 13 inch P.B.H., 6 ft tall
115 X

Hemlock snag bears $S 25^{\circ} E, 30^5$ ft distant
(as per record); tree has partially opened double blaze
we open further to find good "1/4" scribing marks.

From 1962 remonumentation a 26 ins. diam. hemlock
now a 26 inch D.B.H. 4 ft tall hemlock snag bears
 $S 03^{\circ} E, 46^{\pm}$ ft (slope distance) distant (record $S 03^{\circ} E 46^2$ ft
distant); tree has opened single blaze with scribing
RENEWAL
Monument Set: (Procedure and Description) 1/4 S 26 BT visible.

Because bearing and distances to evidence
of original trees agree and the bearing to
the remonumentation tree agrees we accept a
monument location as determined by this evidence
and disregard the slope distance discrepancy
by assuming the distance to the 1962 BT was
measured on the slope.

However this original position is now virtually in
a creek because of nearby road work.

Therefore a witness corner is placed 10° ft
due East of original monument location. This
witness corner is monumented with a DCSC
 $2\frac{1}{2}$ inch brass cap on a $1\frac{1}{2}$ inch iron pipe 30 inches long.

Location and Comments:

Compass Declination

Agency

Party Chief

Notekeeper

Witnesses

DATE: Jan 27, 1981.

Condition Report Only
Not Found
 Renewed
Unrecorded
Surveyed In
Referenced Out

WC
T25S R2W
1/4 S23 cont'd
S26

Previous Renewal #'s 1962 BLM Surveys

Monument(s) Found: ^{Set procedure descrip. cont'd} (~~Condition and Source~~) New cap and pipe

are firmly set and protrudes 2 inches from soil.

Cap is marked "DOUGLAS COUNTY SURVEYOR"

T25 S

WC

S23

← 1/4

S26

R2W

1981

New

Accessories Found: (~~Condition and Source~~) Description

The original south east bearing tree now a 13" DBH hemlock snag as previously described bears $S04^{\circ}W$, 15^3 ft distant

The 1962, 26 inch hemlock as previously described bears $S10^{\circ}W$, 46^8 ft distant. A

boat spike in a 47 inch diam fir stump bears $N19^{\circ}E$, 6^38 ft distant and is stamped "WC" B01

A boat spike in a 49 inch diam. fir stump bearing
S 82 1/2° E, 35⁸¹ ft. distant and is stamped "WC"
B02
All four bearing objects are tagged with
new DCSO, B7 tags

RENEWAL

Monument Set: (Procedure and Description) _____

New Accessories: (Description) _____

Location and Comments: _____ 19° E _____ Compass Declination

DCS Deputy Stephen John Flause
Stephen John Flause

Agency
Party Chief
Notekeeper



COLLEEN O'TOOLE Witnesses

Rm. 122 - COURTHOUSE
ROSEBURG, OR 97470


DOUGLAS COUNTY SHERIFF

PH: 672-3311
EXT. 114

Section 23 Twp. 25 Rge. 2W

Date 1-13-81

Condition of Corner and Accessories: SOME B.T.'S EXIST

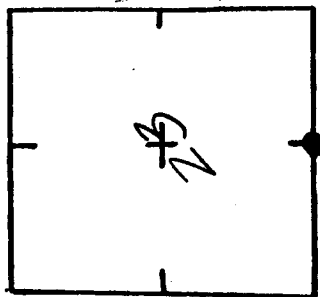

TO REACH: (Please show approximate distances, clearcuts, roads, fences, etc.) SEE ATTACHED SHEET

Notify immediately prior to renewal visit? Yes X No

Notify following renewal visit? Yes X No

Is corner in immediate danger of being lost or disturbed? Yes X No

CORNER HAS BEEN DESTROYED.

Name WELL'S LOGGING CO.

Address 1182 CURRY RD.

Telephone 673-3303

ROSEBURG, 97470

ASK FOR GENE OR CAROLEA

WELL'S

ADDITIONAL COMMENTS PLEASE SEND A COPY OF RENEWAL AFTER

COMPLETION.

[Handwritten signature]
A.P.