



DATE: Feb 2, 1980¹⁹⁸¹

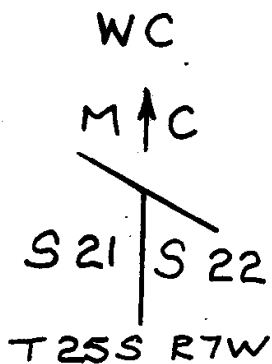

- Condition Report Only
- Not Found
- Renewed
- Unrecorded
- Surveyed In
- Referenced Out

Previous Renewal #'s 1968 BLM Resurvey

Monument(s) Found: (Condition and Source) A 2 1/2" by 28" iron pipe with a brass cap marked "US DEPT. OF THE INTERIOR" from the corner position by the Umpqua River.

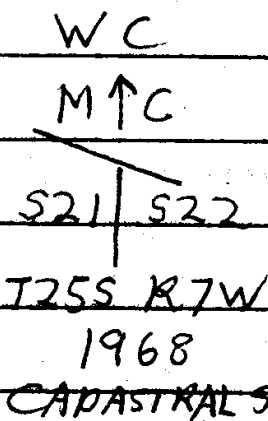

Subsequently they were recovered and brought to the Douglas County surveyors office by a property owner.

Accessories Found: (Condition and Source) From 1968 BLM resurvey An original 32" now a 35 inch D.B.H. ~~tw~~ ash twin Ash bears S 66 1/2° E, 22 1/4 ft. distant (as per record); tree has X in bark at breast height and a low, well healed blaze. An original 37 inch now a 45 inch D.B.H. Cottonwood bears N 23 3/4° W, 61 1/4 ft distant (as per record); tree

#123 ✓

has X in bark at breast height and a low, fully healed single blaze.

RENEWAL

Monument Set: (Procedure and Description) After finding
1968 resurvey
original monument location from 1968 bearing
trees we replace ^{1968 original resurvey} A brass cap and iron
pipe in this location. Cap is now firmly
set and protrudes 6 inches from soil.
We add to the cap the stamping "RESET CS 1980"

New Accessories: (Description) A double trunk Laurel
measuring 7 inches D.B.H. and 11 inches D.B.H.
bears N42 1/2° E, 7 1/2 ft. distant. The 11 inch
trunk is scribed WC/MC S21 S22 CS BT
on a double blaze. No other reasonable
trees available. All trees are marked with
DCSO B.T. tags.

Location and Comments: 19° E Compass Declination
DCSO Agency
Deputy Stephen John Flause Party Chief
Stephen John Flause Notekeeper
D. STEWART Witnesses
K. MOSELEY

OK 