

DATE: March 11, 1981

Condition Report Only

Not Found

Renewed

Unrecorded

Surveyed In

Referenced Out

T25S R6W

1/4 S17 | S16

Previous Renewal #'s 126

Monument(s) Found: (Condition and Source) From renewal #126

2 1/2 inch

a stone and a DCSO brass cap on a 1/2 inch iron pipe protrude 7 inches and 8 inches, respectively, from the soil; both monuments are firmly set, the brass cap is leaning slightly west and is on the east side of the stone. The cap is marked "COUNTY SURVEYORS OFFICE"

The stone (unrecorded when set) is exposed and found to measure 6x6x21 inches long and is marked with a small "x" on top and is marked "1/4 S" on the east face.

T25S
1/4 S17 | S16
R6W
1963

(stone is covered again and soil is firmed)
Accessories Found: (Condition and Source) This area has recently been cleared for pasture, most trees and stumps have been removed and land has been graded. A thorough search is made for all original and renewal bearing trees. No bearing trees are found except possible evidence of roots from the 10 inch D. fir (renewal #126) bearing N 7° W, 47³ ft.

#188X

We check original line calls and find very close agreement with call North to the top of hill, 12⁵ chains distant; The call South to a stream bed 15 chains distant we find to be short some 15-20 ft. however due to meandering and eroding nature of this small stream, some change of position in 128 years can RENEWAL be expected.

Accessories cont'd
 Monument Set: (Procedure and Description) From a Garrett survey filed in DCSO records as map file M56-19 we find a 1 inch iron pipe protruding 1 inch from ground and firmly set, bearing N01°W, 807⁵ feet distant (record N 01° 06' 15" W, 807⁴¹ feet) This survey also recorded finding the bearing trees of renewal #126 at record bearings and distances from the brass cap. We accept monument location.

New Accessories: (Description)
 A 26 inch D.B.H White oak bears S57¹/₂°E, 530⁰ feet distant and is scribed 1/4 S16 CS BT on a double blaze; this tree also has a natural scar on the northeast side near the ground. A 30 inch DBH White oak bears S02°W 38² feet distant and is scribed 1/4 S17 CS BT on a double blaze. We tag the new bearing trees with DCSO, BT tags.

Location and Comments:	<u>19°E</u>	Compass Declination
	<u>DCSO</u>	Agency
<u>Deputy Stephen John Elause</u>		Party Chief
<u>Stephen John Elause</u>		Notekeeper
<u>Karen Mosely</u>		Witnesses
<u>Terri Plouffe</u>		

02/11/11


CORNER RENEWAL REQUEST

Section 25 Twp. 6 Rge. 6

Date 10-7-80

Condition of Corner and Accessories: 1/4 Cor 17 X 16

Chain project - 2nd B.T.S found except
7" D.I.F.R N 27°E 15' Circumferential Board -

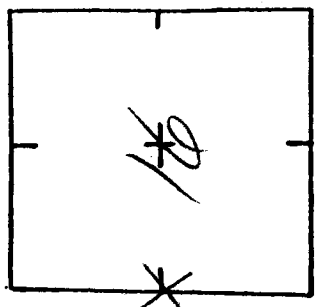

2nd fence any more

F.P. up brass cap still in -

TO REACH: (Please show approximate distances, clearcuts, roads, fences, etc.)

To the Charles - turn
West. 1/4 to 1/2 the way through they - to 1/2 of
mile marker - that driveway is right of the
4 mile - 1/2 mile to farm house - continue thru
2 gates 2nd gate lot beginning of clearcut area - to
about 200 yards - 9 yard up hill to sig.

Notify immediately prior to renewal visit? Yes No

Notify following renewal visit? Yes No

Is corner in immediate danger of being lost or disturbed? Yes No

Name Bruce Steffenberg
Address _____

Telephone 457-1216

ADDITIONAL COMMENTS

Can't stop at farm house if you want but you
Don't need keys or permission -