

OFFICE COPY
LEGEND

SURVEY DIAGRAM

O = Corner having information on form 7100-52 in this file.

CORNER-STATUS

- NO.
- 1 ●
- 2 ●
- 3 ●
- 4 ●
- 5 ●
- 6 ●


USLM No. 192

FILING INSTRUCTIONS

Draft tract diagram in space at left. File 7100-52 card record in numerical sequence behind tract file guide as the data are obtained and recorded. Show by above symbol, on the tract diagram those corners having data in this file.

Comer received from Standard Survey (Survey)

FILED
RECEIVED *JH*
MAR 31 1981
COUNTY SURVEYOR
DOUGLAS COUNTY, ORE.

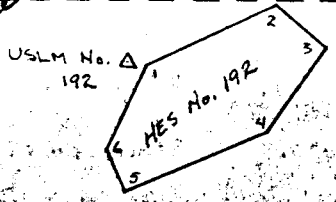

CORNER RECORD FILE GUIDE-(Metes & Bounds Surveys)

GPO 922-851

7100-56 (REV. 3/67)

USDA-FOREST SERVICE GPO 940-117

Index File No. _____ CORNER RECORD (SEARCH) (Ref. FSM 7151.4) Tract or Survey No. HES 192 Cor. No. 1
 T 29 S R. 2 E R.D. Tiller County Douglas
 Merid. _____ N.F. Umpqua State Oregon

CORNER DIAGRAM

DESCRIBE CORNER MONUMENT FOUND

Corner No. 1 of H. E. S. #192.
 Found - Old Corner Stone, in place & mkd: "+" on top and "1 HES 192".
 3- Orig. 14", now 28" Pine, alive, N. 64° E. 9.2 ft., shows scar, we Tag.
 Hole in ground where other Orig. BT. stood.
 Set - Brass Cap at Cor. Mkd: County Surveyor's Office, 1969
 (Reset Stone alongside) T 29 S R 2 E Cor. #1 HES 192
 New BT's: 14" D. Fir S. 81° W. 12.9 ft. mkd: "1 HES 192 CS BT"
 9" Cedar N. 54° E. 11.1 ft. mkd: "1 HES 192 CS BT"
 This corner lies on flat, gently sloping N. E.

FOUND OLD HEALED BLAZE Tracy BELOW C.S. 12/2/69 H. BLAZE. UNRECORDED

PHOTO IDENTI

Photo No. _____
 Filed At _____
 Object Ident. _____
 Ident. By _____
 Signature _____

DESCRIBE CORNER LOCATION RELATIVE TO NEAR-BY FEATURES, ALSO HOW TO REACH CORNER

PLANE COORDINATE POSITION DATA

State _____ Zone _____
 X _____
 Y _____
 Estab. By _____
 Agency _____

Signature _____ Title _____ Division _____ Headquarters _____ Date _____

C. S. File No. 61/19-21

7100-52 (3/68)

Index
File No.

CORNER RECORD (SEARCH)

(Ref. FSM 7151.4)

Tract or Survey No. HES 192 Cor. No. 4

T 29 S R. 2 E R.D. Tiller County Douglas
Merid. _____ N.F. Umpqua State Oregon

CORNER DIAGRAM

DESCRIBE CORNER MONUMENT FOUND

25 MARCH 1969



Corner No. 4 of H. E. S. #192.
Found - Corner Stone, in place, mkd: "4 HES 192" on side facing claim.
Orig. 10", now 27" Pine, alive, N.40 3/4° E. 33.0 ft., shows scar, we tag.
Orig. 42", now 48" Fir, alive, S.25° E. 5.3 ft., shows very good scar, we tag. 2
Set - Brass Cap at Cor. Mkd: County Surveyor's T 29 S R 2 E
(Reset Stone alongside) Office, 1969 Cor. # 4 HES 192
New BT"s: 11" D. Fir N.62 1/2° W. 23.9 ft. mkd: "4 HES 192 CS BT".
7" D. Fir N.34° E. 20.6 ft. mkd: "4 HES 192 CS BT".

PHOTO IDENT This corner lies on southwest slope.

Photo No. _____
Filed At. _____
Object Ident. _____
Ident. By _____
Signature _____

FIRM PROS 12' ABOVE GROUND

Tracy
12/3/69

DESCRIBE CORNER LOCATION RELATIVE TO NEAR-BY FEATURES, ALSO HOW TO REACH CORNER

PLANE COORDINATE POSITION DATA

State _____ Zone _____
X _____
Y _____
Estab. By _____
Agency _____

Signature _____ Title _____ Division _____ Headquarters _____ Date _____ 7100-52 (3.68)

Index
File No.

CORNER RECORD (SEARCH)

(Ref. FSM 7151.4)

Tract or Survey No. HES 192 Cor. No. 5

T 29 S R. 2 E R.D. Tiller County Douglas
Merid. _____ N.F. Umpqua State Oregon

CORNER DIAGRAM

DESCRIBE CORNER MONUMENT FOUND

25 MARCH 1969



Corner No. 5 of H. E. S. #192.
Found - Remains of very old cedar post with scribe marks " -HES 192",
laying on ground.
Orig. 24", now 30" Fir, alive, S.57 1/2° W. 37.6 ft., shows good scar, we tag. 2
Orig. 8", now 16" Fir, alive, S.66° E. 20.5 ft., shows good scar.
We Rescribe "5 HES 192 CS BT".
Set - Brass Cap at Cor. Mkd: County Surveyor's T 29 S R 2 E
Office, 1969 Cor. # 5 HES 192
New BT: 11" D. Fir N.44 1/2° E. 25.2 ft. mkd: "5 HES 192 CSBT"

PHOTO IDENT This corner lies on the flat.
Photo No. _____
Filed At. _____
Object Ident. _____
Ident. By _____
Signature _____

FIRM PROS 12' ABOVE GROUND

Tracy
12/2/69

DESCRIBE CORNER LOCATION RELATIVE TO NEAR-BY FEATURES, ALSO HOW TO REACH CORNER

PLANE COORDINATE POSITION DATA

State _____ Zone _____
X _____
Y _____
Estab. By _____
Agency _____

Signature _____ Title _____ Division _____ Headquarters _____ Date _____ 7100-52 (3.68)

FILED
RECEIVED *TR*

MAR 31 1969

COUNTY SURVEYOR
DOUGLAS COUNTY, ORE.

Index
File No.

CORNER RECORD (SEARCH)

(Ref. FSM 7151.4)

Tract or
Survey No.

Cor.
No

T 295 R. 2E R.D. Tiller County Douglas Survey No. HES 192 Cor. No 6

Merid. _____ N.F. Umpqua State Oregon

CORNER DIAGRAM

DESCRIBE CORNER MONUMENT FOUND



Corner No. 6 of H. E. S. #192.

Found - Old Corner Stone, in place, mkd: "6 HES192" on claim side.

Orig. 16", now 30" Fir, alive, S. 12 3/4° W. 47.5 ft., shows good scar, we tag.

Orig. 16", now 24" Fir, alive, S. 84 1/3° W. 14.5 ft., shows good scar, we tag.

Set - Brass Cap at Cor. Mkd: County Surveyor's T 29 S R 2 E
(Reset stone alongside) Office, 1969 Cor. #6

New BT's: 7" D. Fir N. 45 1/2° W. 25.4 ft. mkd: "6 HES 192 CS BT".

8" D. Fir S. 30° E. 23.0 ft. mkd: "6 HES 192 CS BT".

PHOTO IDENT: This corner lies on moderate, southwest slope.

Photo No. _____
Filed At. _____
Object Ident _____
Ident. By _____

Note - The Old Corner Stones set for the corners of this Homestead Entry Survey #192 are marked with small and hard to find numbers and letters.

Tracy
12/3/69

PLANE COORD

State _____ Zone _____
X _____
Y _____
Estab. By _____
Agency _____

Signature _____ Title _____ Division _____ Headquarters _____ Date _____ 7100-52 (3/68)

Index
File No.

CORNER RECORD (SEARCH)

(Ref. FSM 7151.4)

Tract or
Survey No.


Cor.
No.

T 295 R. 2E R.D. Tiller County Douglas Survey No. HES 192 Cor. No. USLM

Merid. _____ N.F. Umpqua State Oregon

CORNER DIAGRAM

DESCRIBE CORNER MONUMENT FOUND

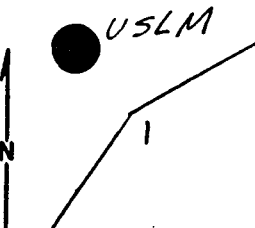

DESCRIBE BEARING TREES OR OTHER OFFICIAL ACCESSORIES FOUND

U. S. L. M. #192.

Found - Orig. Corner Stone, in place but broken, & mkd: "USLM 192".

Orig. 36", now 44" Fir, alive, N. 27° E. 12.5 ft., shows good scar, we tag.

Orig. 14", now 20" Fir, alive, N. 45 3/4° W. 46.2 ft., shows good scar, tag.

Orig. 14", now 26" Pine, alive, S. 22 1/2° E. 110.9 ft., opn & shows "USLM 192 BT"

We Rescribe " USLM 192 CS BT" above old blaze.

Orig. 30", now 38" Fir, alive, S. 24° W. 29.9 ft., shows good scar, we tag.

Set - Brass Cap at Cor. Mkd: County Surveyor's T 29 S R 2 E
(In place of old stone) Office, 1969 USLM 192

This monument lies on top of mountain. Cor. #1, HES 192 bears S. 79° E. 251.9 feet. No other trees available for Bearing Trees.

USLM Ties - We are unable to see Ackers Butte, old trail still in evidence & bears S. 24 feet.

C. S. 54/96

Signature _____ Title _____ Division _____ Headquarters _____ Date _____ 7100-52 (3/68)

FILED
RECEIVED
12/2/69
USFS
MAY 31 1981

COUNTY SURVEYOR
DOUGLAS COUNTY, ORE.