


DATE: APRIL 1, 1981

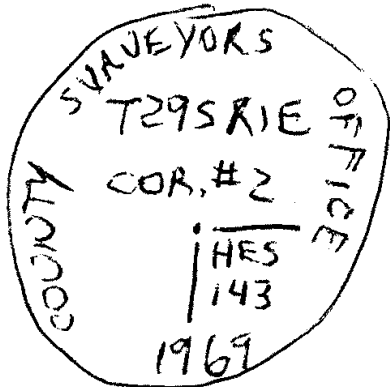

- Condition Report Only
- Not Found
- Renewed
- Unrecorded
- Surveyed In
- Referenced Out

Previous Renewal #'s 17

Monument(s) Found: (Condition and Source) _____

1" d, 1 1/2" H, FIRMLY SET, PROJECTING 4" ABOVE, 2 FT. D,
MOUND OF STONE, WITH BRASS CAP MARKED
AS ABOVE, SET IN 1969 BY VERNON TRACY

Accessories Found: (Condition and Source) _____

ORIGINAL BTS:
A 24" D. FIR STUMP, N44 1/2° E, 24' FT (TO FACE),
PREVIOUSLY OPENED WITH SCRIBE MARKS
"HES 143 BT" VISIBLE.
A 30" D. FIR STUMP, N33 1/2° W, 20' FT (TO FACE), PRE-
VIOUSLY OPENED WITH SCRIBE MARKS "2HES143" VISIBLE.

#168 X

C

AND BT MARKED BY TRACY IN 1969:
A 25" F. CED., N80°E, 108⁷ FT (REC. 107⁶ FT.)
WITH HEALED BLAZE.

RENEWAL

Monument Set: (Procedure and Description)

New Accessories: (Description)

I SCAIBED A NEW BT.:

A 9" D. FIR, N30°W, 26¹ FT, MARKED
"2 HES 143 CS BT" ON DOUBLE BLAZE.

Location and Comments:

18¹/₂° E

US FS

LEONARD HERZSTEIN

JIM LANDRUM

TOM WOLFORD

Compass Declination

Agency

Party Chief

Notekeeper

Witnesses

OK
[Signature]