


DATE: APRIL 1, 1981

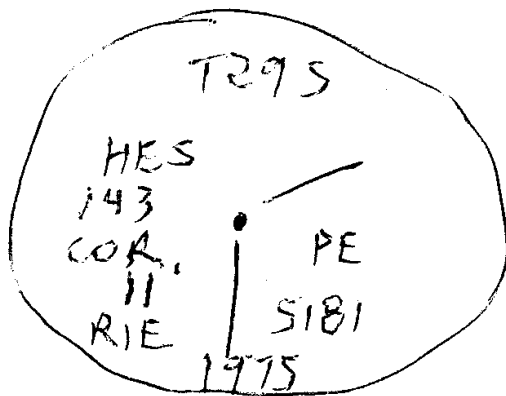

Condition Report Only
 Not Found
 Renewed
 Unrecorded
 Surveyed In
 Referenced Out

Previous Renewal #'s 10Z

Monument(s) Found: (Condition and Source) _____

1" I.P., FIRMLY SET, 10" BELOW ~~GRADE~~ SURFACE OF
U.S.F.S. RD. #2826, WITH BRASS CAP MARKED AS
ABOVE, SET BY MAURICE FARR IN 1975.
CORNER LIES UNDER EAST EDGE OF ROAD.

Accessories Found: (Condition and Source) _____

BTS MARKED BY FARR IN 1975:
A 6" HEM., N71°45'W, 33³ FT., WITH SCRIBE MARKS
"11 HES 143 BT" VISIBLE ON PARTLY HEALED BLAZE.
A ROOT HOLE, N29°00'W, 42⁵ FT, WITH 6" ~~SAND~~
W. FIR LOG. ALONGSIDE WITH SCRIBE MARKS "11 HES
143 BT" VISIBLE ON PARTLY HEALED BLAZE.

#166 J

Q

U.S.F.S.
~~F.A.S.~~

AND A R.M. SET BY ~~U.S.F.S.~~ IN 1975:

A 4" X 4" WOOD POST, BEARS EAST, 5⁰ FT
(TO FACE) WITH LOCATION ~~NO~~ TAG
ATTACHED.

RENEWAL

Monument Set: (Procedure and Description)

New Accessories: (Description)

~~I~~ SCRIBE NEW B.T.:

A 9" D. FIR, N33¹/₂°W, 418 FT., MARKED
"11 HES 143 CS BT" ON DOUBLE BLAZE.

Location and Comments:

20° E
U.S.F.S.
LEONARD HERZSTEIN
JIM LANDRUM
TOM WOLFORD

Compass Declination
Agency
Party Chief
Notekeeper
Witnesses

OK 