


DATE: 4-6-81

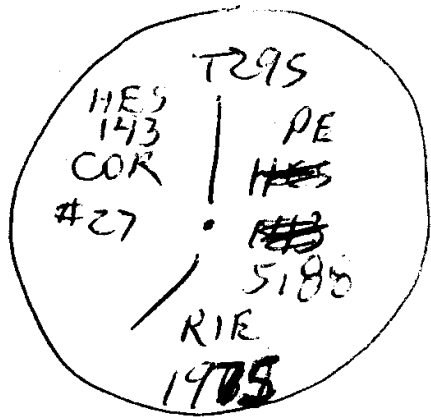

- Condition Report Only
- Not Found
- Renewed
- Unrecorded
- Surveyed In
- Referenced Out

Previous Renewal #'s 31, 110

Monument(s) Found: (Condition and Source) _____

1" d I.P., FIRMLY SET, ~~PROTRUSING~~ FLUSH WITH
3 FT. d, MOUND OF STONE, WITH BRASS
CAP MARKED AS ABOVE, SET BY
MAURICE FARR IN 1975.

Accessories Found: (Condition and Source) _____

BIS MARKED BY TRACY IN 1969:
A 12" d, D. FIR SNAG, N66°E, 140⁸ FT,
WITH S.M. "27 HES 143 CS BT" VISIBLE
ON PARTLY HEALED BLAZE.
A 20" d, D. FIR, S62°E, 152⁵ FT WITH
HEALED BLAZE.

#167 ✓

C

ADDED TO NOTES ~~5~~ 5/20/81:
FOUND REMAINS OF ORIGINAL BTS:

A 25" D. FIR STUMP, N52 1/2° E, 14 1/2 FT. WITH S.M. VISIBLE
ON PREVIOUSLY OPENED BLAZE.

A 30" D. FIR STUMP, S33° E, 37 1/2 FT WITH HEALED
LOWER BLAZE.

RENEWAL

Monument Set: (Procedure and Description) _____

New Accessories: (Description) _____

I SCRIBE NEW BT.:

AN I. CED, 4" d, N24 1/4° E, 13' FT,

MARKED "27 HES 143 CS BT"

ON DOUBLE BLAZE.

Location and Comments:

18° E
U.S. F.S.
LEONARD HERZSTEIN
J. LANDRUM
T. WOLFORD.

Compass Declination
Agency
Party Chief
Notekeeper
Witnesses

OK 