


DATE: APRIL 20, 1981

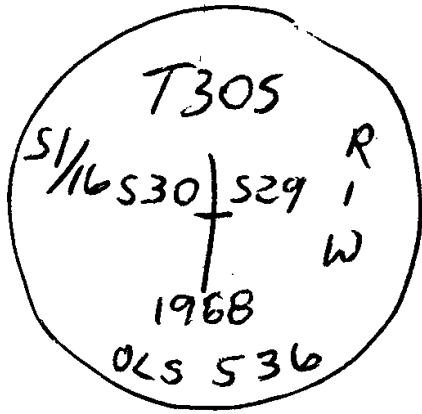

- Condition Report Only
- Not Found
- Renewed
- Unrecorded
- Surveyed In
- Referenced Out

Previous Renewal #'s _____

Monument(s) Found: (Condition and Source) 2" d, IP, FIRMLY SET, PROJECTING 14" ABOVE GROUND, SET BY GLEN BAUGHMAN L.S. #536, IN 1968, WITH B.C. MARKED AS ABOVE.

Accessories Found: (Condition and Source) _____

BTS MARKED BY BAUGHMAN IN 1968 :

A 12" MAD, N40°E, 9³/₄ FT. WITH S.M. "S 1/16 S29 BT" VIS. ON PARTLY HEALED BLAZE.

A 12" MAD. SNAG, S63°W, 35¹/₂ FT (REC. 34⁶/₁₆ FT.) WITH S.M. "S 1/16 S30 BT" VIS. ON PARTLY HEALED BLAZE.

X

RENEWAL

Monument Set: (Procedure and Description)

I ADD ~~A~~ 2' d, MOUND OF STONE, B.C. NOW
PROJECTING 8".

New Accessories: (Description)

I MARK A NEW BT:
A D. FIR, 7" d, S 7 1/2° W, 29'-FT. SCRIBED
"S 1/16 S 30 CS BT" ON DOUBLE BLAZE.

Location and Comments:

20°E
USFS
LEONARD HERCSTEIN
JIM LANDRUM
TOM WOLFORD

Compass Declination
Agency
Party Chief
Notekeeper
Witnesses

OK *[Signature]*