


DATE: APRIL 20, 1981

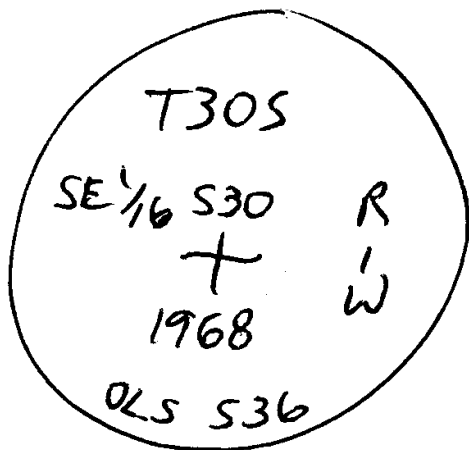

- Condition Report Only
- Not Found
- Renewed
- Unrecorded
- Surveyed In
- Referenced Out

Previous Renewal #'s \_\_\_\_\_

Monument(s) Found: (Condition and Source) 2" I.P. SET BY  
GLEN BAUGHMAN IN 1968, LOOSELY SET, LEANING  
WESTERLY, FACING WEST, PROJECTING 14"  
ABOVE GROUND, WITH B.C. MARKED AS  
ABOVE

Accessories Found: (Condition and Source) \_\_\_\_\_

BTS MARKED BY BAUGHMAN IN 1968:

A) 6" MAD. SNAG, S43°E, 71 1/2 FT. WITH S.M.

" 1/4 S30 TB" VIS. ON PARTLY HEALED BLAZE.

A 16" D. FIR STUMP, N14°E, 48 1/2 FT (REC. 48 1/2 FT.)

WITH S.M. "B" VIS. ON OPENED BLAZE.

- BTS WERE ERRONIOUSLY SCRIBED "TB". -

X

RENEWAL

Monument Set: (Procedure and Description) \_\_\_\_\_

I RESET B.C., NOW FIRMLY SET, PROJECTING  
10" ABOVE 2' d, MOUND OF STONE,

New Accessories: (Description) \_\_\_\_\_

I MARK NEW BTS:

A W. FIR, 10" d, N53°E, 64<sup>6</sup>/<sub>16</sub> FT. SCRIBED  
"SE <sup>1</sup>/<sub>16</sub> S30 CS BT" ON DOUBLE BLAZE,

A O. FIR, 4" d, N70<sup>1</sup>/<sub>2</sub>°W, 59<sup>1</sup>/<sub>16</sub> FT, SCRIBED  
"SE <sup>1</sup>/<sub>16</sub> S30 CS BT" ON DOUBLE BLAZE,

Location and Comments:	<u>18°E</u>	Compass Declination
	<u>USFS</u>	Agency
	<u>LEONARD HERZSTEIN</u>	Party Chief
	_____	Notekeeper
	<u>JIM LANDRUM</u>	Witnesses
	<u>TOM WOLFORD</u>	
	_____	

