


DATE: APRIL 28, 1981

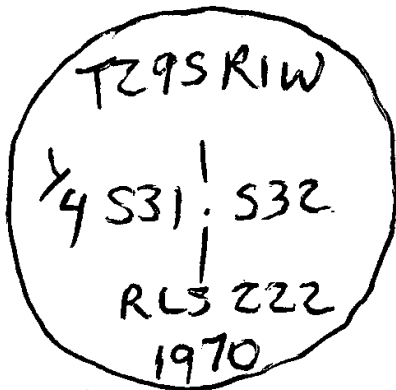

- Condition Report Only
- Not Found
- Renewed
- Unrecorded
- Surveyed In
- Referenced Out

Previous Renewal #'s # 99

Monument(s) Found: (Condition and Source) \_\_\_\_\_

2" d, I.P., SET BY J.A. HOFFBUHR, OLS #222, IN  
1970, FIRMLY SET, PROJECTING 6" ABOVE THE  
GROUND, WITH B.C. MARKED AS ABOVE. WITH  
ORIGINAL BASALT STONE ALONGSIDE.

Accessories Found: (Condition and Source) \_\_\_\_\_

ORIG BT:  
A ROOT HOLE, S78°E, 11<sup>2</sup> FT WITH A ROTTEN  
MADRONE OF INDETERMINATE SIZE ALONGSIDE  
WITH NO MARKS VISIBLE.  
AND BTS MARKED BY HOFFBUHR IN 1970:  
A 13" D. FIR, N83<sup>1</sup>/<sub>2</sub>°E, 50<sup>5</sup> FT, WITH

#133 ✓

C

HEALED DOUBLE BLAZE.

A 9" MAD. SNAG, N87°W, 40<sup>0</sup> FT., WITH S.M. 1/4  
S31 BT" VISIBLE ON PARTLY HEALED DOUBLE  
BLAZE. (REC. 40<sup>0</sup> FT.)

RENEWAL

Monument Set: (Procedure and Description) \_\_\_\_\_

New Accessories: (Description) \_\_\_\_\_

I SCRIBE A NEW BT:

A 6" D. FIR, S16°W, 39<sup>9</sup> FT., MARKED "1/4 S31  
CS BT" ON DOUBLE BLAZE.

Location and Comments:

19°E  
U.S. F.S.  
LEONARD HERZSTEIN  
JIM LANDRUM  
TOM WOLFORD

Compass Declination  
Agency  
Party Chief  
Notekeeper  
Witnesses

*OK [Signature]*