


ON NORTHERLY SIDE OF STUMP I CUT OUT PIECE OF WOOD WHICH SHOWS PARTIALLY HEALED BLAZE. I OPEN AND FIND NO SCRIBING OR AXE MARKS.

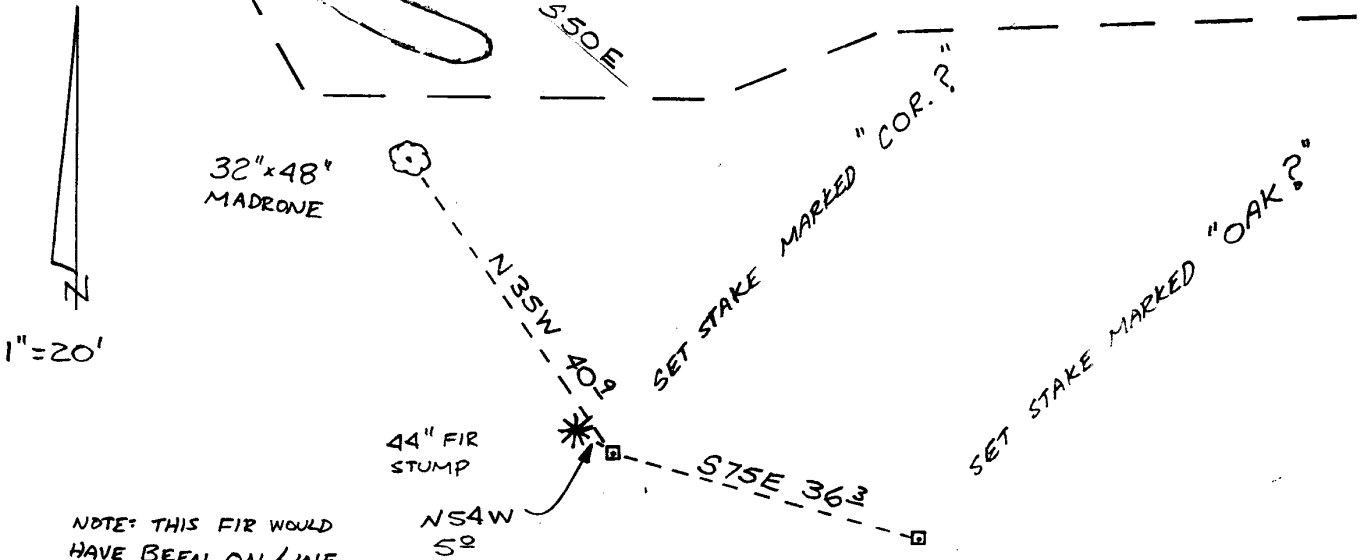

NOTE: THIS FIR WOULD HAVE BEEN ON LINE AND BLOCKED MADROVE FROM FIELD OF VIEW.

NOTE: STAKES WERE SET AT THE REQUEST OF MRS. KOOPMANS FOR HER INFORMATION ONLY AND DO NOT DEPICT THE ACTUAL COR. LOCATION.

GREGORY E. QUIBELL  
JOHN POWELL  
5-20-82

T. 29S. R. 7W.

1/4 S3/S2

REGISTERED  
PROFESSIONAL  
LAND SURVEYOR

*Gregory E. Quibell*

OREGON  
JULY 13, 1979  
GREGORY E. QUIBELL  
1834

FILED  
RECEIVED *JK*  
MAY 21 1982  
COUNTY SURVEYOR  
DOUGLAS COUNTY, ORE.

*OKJEM*