


DATE: MAY 13, 1981

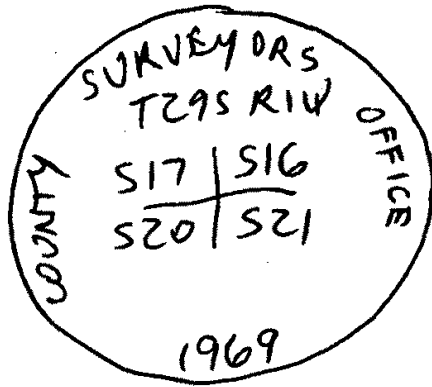

Condition Report On  
 Not Found  
 Renewed  
 Unrecorded  
 Surveyed In  
 Referenced Out

Previous Renewal #'s 35

Monument(s) Found: (Condition and Source)

2" IP. SET BY DOUGLAS CO. SURVEYOR'S OFFICE  
IN 1969, FIRMLY SET, PROJECTING 4" ABOVE  
GROUND, WITH B.C. MARKED AS ABOVE.

Accessories Found: (Condition and Source) ORIG. BT'S :

A 50" D. FIR SNAG, N44°E, 49<sup>±</sup> FT, WITH HEALED  
DOUBLE BLAZE.

A 30" D. FIR STUMP, S32°E, 44<sup>±</sup> FT, WITH S.M.  
"S21" VISIBLE ON PREVIOUSLY OPENED  
BLAZE.

A 16" D. FIR SNAG, N29°W, 32<sup>±</sup> FT, WITH

# 139 ✓

HEALED DOUBLE BLAZE.

AND BTS MARKED BY CO. SURVEYOR'S OFFICE  
IN 1969:

A 8" WHITE FIR (REC. R. FIR), S31°E, 33<sup>2</sup> FT.

RENEWAL

Monument Set: (Procedure and Description)

New Accessories: (Description) I MARKED NEW BTS:

A 14" W. FIR, N45°E, 29<sup>7</sup> FT., SCRIBED "TZ9S  
R1W S16 CS BT" ON DOUBLE BLAZE.

A 8" D. FIR, S5°W, 40<sup>1</sup> FT, SCRIBED "TZ9S  
R1W S20 CS BT" ON DOUBLE BLAZE.

A 11" I. CEDAR, N50°W, 48<sup>9</sup> FT, SCRIBED

Location and Comments:

20°E

U.S.F.S

LEONARD HERTZSTEIN

JIM LANORUM

TOM WOLFORD


Compass Declination

Agency

Party Chief

Notekeeper

Witnesses

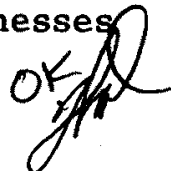OK 

DATE: MAY 13 1981

TZ9S RIW

517	516
520	521

Condition Report On  
 Not Found  
 Renewed  
 Unrecorded  
 Surveyed In  
 Referenced Out

Previous Renewal #'s \_\_\_\_\_

Monument(s) Found: (Condition and Source) \_\_\_\_\_

Accessories Found: (Condition and Source) \_\_\_\_\_

WITH HEALED DOUBLE BLAZE.

A 14" SUGAR PINE SNAG (REC. Y. PINE), S12°W,  
 44<sup>3</sup> FT. WITH S.M. "TZ9S RIW 520 CS BT"  
 VISIBLE ON PARTLY HEALED BLAZE.

#139 ✓

RENEWAL

Monument Set: (Procedure and Description) \_\_\_\_\_

New Accessories: (Description) \_\_\_\_\_

"T29S RIW S17 CS BT" ON DOUBLE BLAZE.

Location and Comments: \_\_\_\_\_  
\_\_\_\_\_  
\_\_\_\_\_  
Compass Declination  
Agency  
Party Chief  
Notekeeper  
Witnesses