


DATE: MAY 18, 1981

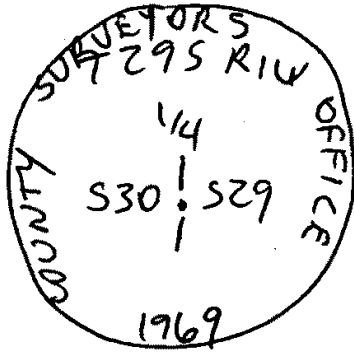

Condition Report On
 Not Found
 Renewed
 Unrecorded
 Surveyed In
 Referenced Out

Previous Renewal #'s BZ

Monument(s) Found: (Condition and Source) _____

1/4" IP., SET BY JOHN POWELL, DEPUTY CO.
SURVEYOR, IN 1969, FIRMLY SET, PROJECTING
14" ABOVE GROUND, WITH BRASS CAP
MARKED AS ABOVE. ORIGINAL CORNER
STONE WITH MARKS "1/4" VISIBLE IS SET
ALONGSIDE.

Accessories Found: (Condition and Source) ORIGINAL BTS:

A 40" D. FIR STUMP, N43°E, 33⁰ FT, WITH
SCRIBE MARKS "29" VISIBLE ON PREVIOUSLY
OPENED BLAZE.

A ROOTHOLE, N45°W, 8⁶ FT, WITH 16" CEDAR LOG
ALONGSIDE WITH NO MARKS VISIBLE.

AND BTS MARKED BY POWELL IN 1969:

Page _____ of _____

C. S. File No. 61/24-22 ✓

A 14" D. FIR (REC. R. FIR), N33°E, 34⁶ FT, WITH

HEAVED DOUBLE BLAZE.

A 12" I. CEDAR, S73°W, 16⁷ FT, WITH HEAVED

DOUBLE BLAZE.

RENEWAL

Monument Set: (Procedure and Description) _____

New Accessories: (Description) _____

Location and Comments:

Compass Declination

USFS

Agency

LEONARD HERTSTEIN

Party Chief

Notekeeper

JIM LANDRUM

Witnesses

TOM WOLFORD

OK
