


DATE: MAY 20, 1981

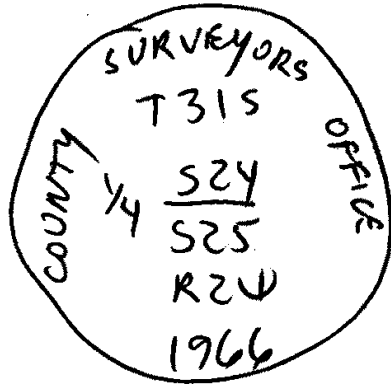

Condition Report On  
 Not Found  
 Renewed  
 Unrecorded  
 Surveyed In  
 Referenced Out

Previous Renewal #'s 63

Monument(s) Found: (Condition and Source) \_\_\_\_\_

1" IP SET BY JOHN POWELL, DEPUTY CO. SURVEYOR  
IN 1966, FIRMLY SET, PROJECTING 4" ABOVE  
GROUND, WITH B.C. MARKED AS ABOVE.

Accessories Found: (Condition and Source) ORIGINAL BT:

A 17" MADRONE SNAG, N65°E, 18<sup>5</sup> FT, WITH  
SCRIBE MARKS "BT" VISIBLE ON PREVIOUSLY  
OPENED BLAZE.

AND BTS MARKED BY POWELL IN 1966:

A 17" D. FIR, S58°E, 37<sup>3</sup> FT. WITH HEALED  
DOUBLE BLAZE.

217  
#122

✓

Page \_\_\_\_\_ of \_\_\_\_\_

C. S. File No. 61/24-29

A 14" D. FIR SNAG, N38°W, 21° FT., WITH S.M.

"1/4 SZY CS BT" VISIBLE ON PARTLY HEAVED  
BLAZE.

RENEWAL

Monument Set: (Procedure and Description)

New Accessories: (Description)

I MARK NEW BT:

A 9" I. CEDAR, N61°W, 70<sup>3</sup> FT., SCRIBED "1/4  
SZY CS BT" ON DOUBLE BLAZE.

Location and Comments:

B.C. IS JUST  
OUTSIDE FENCE  
CORNER, FENCE  
BEARS SOUTH  $\frac{1}{2}$  WEST.

21° E.  
USFS  
LEONARD HERTSTEIN  
JIM LANDRUM  
TOM WOLFORD

Compass Declination  
Agency  
Party Chief  
Notekeeper  
Witnesses

OK  
*[Signature]*