

T 29 S R 1 E

DATE: 5-21-81

16	15
21	22

- Condition Report Only
- Not Found
- Renewed
- Unrecorded
- Surveyed In
- Referenced Out

Previous Renewal #'s \_\_\_\_\_

Monument(s) Found: (Condition and Source) FD. orig 1921

BRASS CAP FIRMLY SET 10" OUT OF  
THE GROUND, LEANING SLIGHTLY TO  
THE EAST.

Accessories Found: (Condition and Source) FD. orig. 16" now

19" FIR WITH WELL HEALED BLAZE BEARS S43°W  
42<sup>9</sup> FT.

FD. orig 14" now 22" FIR WITH WELL HEALED  
BLAZE BEARS N 67° W 25° FT. (Rec. 24<sup>9</sup>)

THERE IS NO TRACE OF THE OTHER  
TWO ORIG. TREES.

#1781 ✓

U. S. File No. 61/27-1 Page \_\_\_\_ of \_\_\_\_

FD 32" FIR (NOT OF RECORD) WITH OLD  
U.S.F.S. LOCATION POSTER & LARGE BLAZED "X"  
BEARS N 86° E 13° FT.

RENEWAL


Monument Set: (Procedure and Description) \_\_\_\_\_

NA

New Accessories: (Description) 10" YEW BEARS S 42° E  
38<sup>1</sup>/<sub>2</sub> FT SCRIBED "T 295 R 1 E S 22 CS BT" IN  
DOUBLE BLAZE.

8" FIR BEARS N 19° E 23<sup>1</sup>/<sub>2</sub> FT SCRIBED  
"T 295 R 1 E S 15 CS BT" IN DOUBLE BLAZE  
ALL TREES HAVE DCSO BT TAGS.

Location and Comments:  
(NOT TO SCALE)

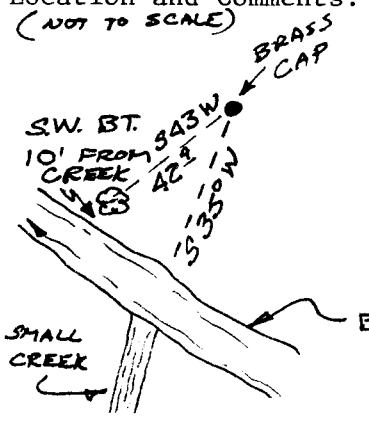

19° E  
DCSO  
Gregory E. Ziebell  
Greg Durrell  
TERRIE FLOUFE

Compass Declination  
Agency  
Party Chief  
Notekeeper  
Witnesses

OK  
[Signature]