


DATE: SEPT. 17, 1981

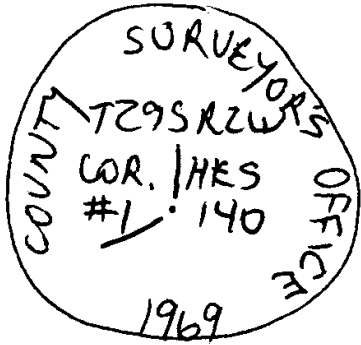

- Condition Report Only
- Not Found
- Renewed
- Unrecorded
- Surveyed In
- Referenced Out

Previous Renewal #'s 57

Monument(s) Found: (Condition and Source) _____

1/4" IP., SET FIRMLY, PROJECTING 3"
ABOVE GROUND, WITH BRASS CAP MARKED
AS ABOVE, SET IN 1969 BY JOHN POWELL,
DOUGLAS COUNTY SURVEYOR'S OFFICE.

Accessories Found: (Condition and Source) ORIGINAL BTS:

A 20" D. FIR STUMP, S30°E, 31⁰ FT., WITH
NO MARKS VISIBLE.

A 22" D. FIR STUMP, N49¹/₄°W, 29⁷ FT., WITH
SCRIBE MARKS "HES" VISIBLE ON
PREVIOUSLY OPENED BLAZE.

AND BTS MARKED BY POWELL IN 1969:

✓

A 9" D. FIR, N6°E, 19⁶ FT., WITH HEALED BLAZE.

A 6" D. FIR, N41½°W, 35⁷ FT., WITH HEALED
BLAZE.

RENEWAL

Monument Set: (Procedure and Description) _____

New Accessories: (Description) _____

Location and Comments:

CORNER IS IN
CUT BANK OF
OLD DIRT RD.

U.S.F.S.
LEONARD HERZSTEIN
JIM LANDRUM
JERRY PIERCE

Compass Declination

Agency

Party Chief

Notekeeper

Witnesses

OK
J.M.