


DATE: SEPT. 21, 1981

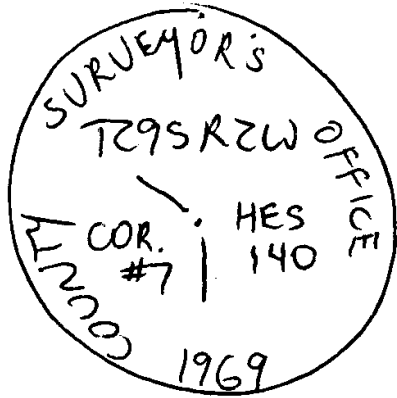

Condition Report Only
 Not Found
 Renewed
 Unrecorded
 Surveyed In
 Referenced Out

Previous Renewal #'s 63

Monument(s) Found: (Condition and Source) _____

1 1/4" I.P., FIRMLY SET, PROTECTING 15" ABOVE
GROUND, WITH BRASS CAP MARKED AS SHOWN
ABOVE, SET BY DOUGLAS COUNTY SURVEYOR'S
OFFICE IN 1969. ORIGINAL CORNER IS
ALONGSIDE WITH MARKS " + " ON NORTH SIDE
AND " 7 HES 140 " ON TOP.

Accessories Found: (Condition and Source) ORIGINAL BTS:

- a) 24" D. FIR, S4°W, 12[±] FT., WITH HEALED DOUBLE BLAZE.
- a) 18" I. CEDAR SNAG, N73°W, 19[±] FT, WITH HEALED
DOUBLE BLAZE.

AND BT MARKED BY CO. SURVEYORS OFFICE IN 1969:

- a) 7" D. FIR SNAG, N62°W, 4'-FT., WITH SCRIBE MARKS
" 7 HES 140 CS BT " VISIBLE ON PARTLY HEALED BLAZE.

#118 ✓

RENEWAL

Monument Set: (Procedure and Description) _____

NONE

New Accessories: (Description) I MARK

NEW BT:

a) 12" D. FIR, N78°E, 36⁸ FT. SCRIBED " 7 HES
140 CS BT" ON DOUBLE BLAZE.

Location and Comments:

CORNER IS
100' SOUTH
USFS RD.
#274-P

19¹/₂° E
U. S. F. S.
LEONARD HERSTEIN
JIM LANDRUM
JERRY PIERCE

Compass Declination
Agency
Party Chief
Notekeeper
Witnesses

OK
