

T 21 - 11  
33/34  
7/3  
T 22 - 11

DATE: 10/2/81

- Condition Report Onl
- Not Found
- Renewed
- Unrecorded
- Surveyed In
- Referenced Out

Previous Renewal #'s 19 (T 21 - 11)

Monument(s) Found: (Condition and Source)

18"X18"X6" sandstone with "X" on top, set by W. Hootman in 1959

Accessories Found: (Condition and Source)

✓34" D-fir, brs. N39°E, dist. 14<sup>3</sup>, healed face

43" D-fir, brs. N21°W, dist. 20<sup>5</sup>, Chopped out face, The face was cut out approx. 48 yrs. ago. All heartwood is rotten inside (has deteriorated to powder). No scribing found. Traces of ax marks found only. Tree has dead top. (Cut out, found the upper bevel part of blaze).

✓47" Douglas-fir, brs. S82°W, 57<sup>7</sup>, healed face.

SE Cherry BT is down-uprooted. Part of scribing is still visible.

#147 - T21-11  
#154 - T22-11

C. S. File No. 61/29-3

C

RENEWAL

Monument Set: (Procedure and Description) \_\_\_\_\_

Set 2½" brass cap on 1" iron pipe, 30" long w/flanged bottom,  
stamped: \_\_\_\_\_


DOUGLAS COUNTY  
SURVEYOR'S OFFICE

T21S	R11W
S33	S34
S4	S3
T22S	R11W

New Accessories: (Description) \_\_\_\_\_ 1981

6" D-fir, brs. S46°E, dist. 25<sup>2</sup>, "X" scribed at breast height,  
lower blaze scribed CSBT.

Location and Comments: \_\_\_\_\_ 20°E \_\_\_\_\_ Compass Declination  
LOCATION: Go East along \_\_\_\_\_ USFS \_\_\_\_\_ Agency  
Hwy. #38 approx. 4.6 mi. Ernesto R. Alvarado Party Chief (Douglas  
from Reedsport to Alder- Carol Dickison Notekeeper Co. Dep.  
wood Farm Walk west on \_\_\_\_\_ Colin Long \_\_\_\_\_ Witnesses Surveyor  
road south of creek (S  
edge of pasture) approx. \_\_\_\_\_  
600' to location poster on Alder on South  
side of road. From poster, go S10°W, 500' to corner.

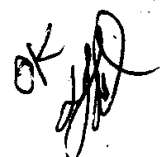OK 

T215 R11W  
Sec Cor.  
R-19

43" D-Fir  
Brs. N21°W  
Dist. 205'  
Face was chopped into  
approx. 48 yrs. ago. Wood  
is rotten inside - no  
chairs deteriorated to powder  
Scribing found traces  
of av mks. found only  
"Tree has dead top


47" D-Fir  
Brs. S82°W  
Dist. 572'  
Healed face

Location:  
5.0 mi. Hwy #38, approx. 4.6 mi.  
to Alderwood Farm. Walk west on rd.  
5.0 mi. to

From post, go S10°W 100'  
15'

Found  
sandstone w/ "x"  
on top set by Hoolman  
in 1954 (18" X 18" X 6")

X Stone is alongside cap.  
set 2 1/2" brass cap on  
Healed face  
4" I.P. 30" long  
w/ flanged bottom  
stamped

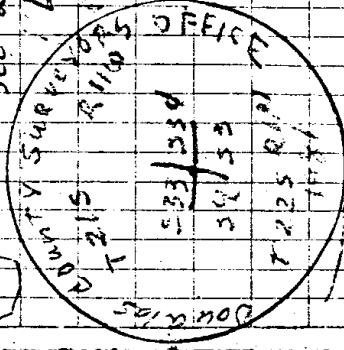

X SE BT: Cherry  
is down (up rooted)  
& rotten. Part  
of scribing still  
visible

New BT:  
6" D-Fir  
Brs. S46°E  
Dist. 253'

X "scribe @ breast height  
Lower blaze scribed CSBT