

T 29 S R 1 E

DATE: 10-12-81

1/4
9
—
16

Condition Report Only
Not Found
 Renewed
Unrecorded
Surveyed In
Referenced Out

Previous Renewal #'s 67

Monument(s) Found: (Condition and Source) FD. ORIG 1921

BRASS CAP FIRMLY SET PROTRUDING 10"
OUT OF GROUND MARKED:

1/4 S 9
S 16
1921

Accessories Found: (Condition and Source)


FD. ORIG. 18" NOW 25" FIR WITH WELL
HEALED SCAR BEARS S 72° W 12³ FT.

ORIG. 8" FIR 3/4s. FROM COR. IS
COMPLETELY GONE.

#185 ✓

RENEWAL

Monument Set: (Procedure and Description) _____

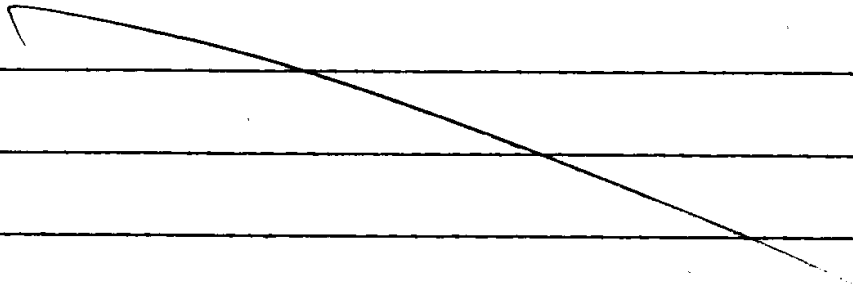

New Accessories: (Description) _____

- 13" FIR BEARS N 18° W 51² FT SCRIBED "1/4 S 9 CS BT"
- IN DOUBLE BLAZE. 13" FIR BEARS N 21° E 27² FT SCRIBED "1/4 S 9 CS BT" IN DOUBLE BLAZE.
- 13" FIR BEARS S 80° E 12² FT SCRIBED 1/4 S 16 CS BT IN DOUBLE BLAZE

Location and Comments: 19° E Compass Declination

DCSD Agency
Garry E. Zwick Party Chief
GREG GUNDEL Notekeeper
TERRIE PLOUFE Witnesses
TERESA BULEY
COR IS S 20° W
75' ± OF OLD
DIRT LOGGING
ROAD.

OK
JEM