

T255 RIW

1/4

S27 | S26

DATE: 10-26-81

- Condition Report Only
- Not Found
- Renewed
- Unrecorded
- Surveyed In
- Referenced Out

Previous Renewal #'s #60

Monument(s) Found: (Condition and Source) FD. BRASS CAP PER

REN #60 FIRMLY SET AND MARKED:

COUNTY SURVEYORS OFFICE

T255 RIW

1/4

S27 | S26

1966

Accessories Found: (Condition and Source)

FD. ORIG. 15" FIR NOW 24" HEMLOCK SNAG 30' HIGH,

WITH SCRIBED "S" VISIBLE IN PREVIOUSLY OPENED BLAZE,

BEARS S25W 5³ (REC. S35W) FD. ORIG. 18"

NOW 30" HEMLOCK STUMP WITH GOOD SCAR BEARS

N68°E 23¹. FD. 10" NOW 12" HEMLOCK PER

REN. #60 WITH "1/4 S27CS BT" VISIBLE IN UNHEALED

#155 ✓

C.S. 61/29-17

Page of c

BLAZE BEARS S 56° W 10^B (REC. S 58 W)


FD. 17" NOW 22" HEMLOCK STUMP, PER REN #60

WITH "1/4 S 26 CS BT" VISIBLE IN UNHEALED BLAZE

BEARS N 29° E 44^B.

RENEWAL

Monument Set: (Procedure and Description)

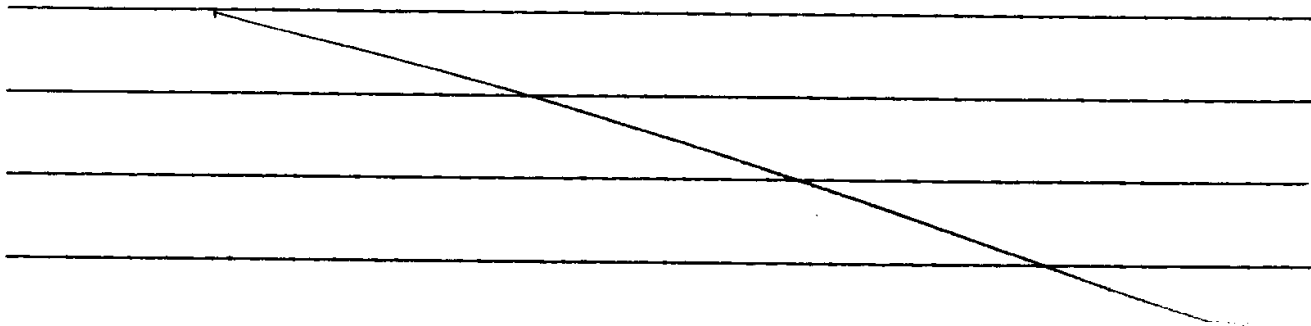

New Accessories: (Description)

7" HEMLOCK SCRIBED "1/4 S 26 CS BT" IN DOUBLE BLAZE BEARS

N 34° E 42³. 12" HEMLOCK SCRIBED "1/4 S 26 CS BT"

IN DOUBLE BLAZE BEARS S 56° E 61³.

20" HEMLOCK SCRIBED "1/4 S 27 CS BT" IN DOUBLE

BLAZE BEARS S 74° W 77³.

Location and Comments:

19° E

Compass Declination

DC 50

Agency

Gregory C. Ziebell Party Chief

Greg Quibell Notekeeper

TERESA BULEY Witnesses

OK [Signature]