

T 24 S R 4 W

DATE: 11-23-81

1/4 S 24
(ONLY)

Condition Report Only
 Not Found
 Renewed
 Unrecorded
 Surveyed In
 Referenced Out

Previous Renewal #'s 1950 RESURVEY

Monument(s) Found: (Condition and Source) U.S. GENERAL LAND OFFICE

CAP MONUMENT
BRASS-STAMPED STAMPED " 1/4 S 24 | "

1950

MONUMENT PROTRUDES 10 INCHES ABOVE GROUND.

Accessories Found: (Condition and Source) A MAPLE 6 NOW 9 INCH

DIAMETER WITH A WELL HEALED BLAZE BEARS S 11 1/2° W 340[±] FEET
(REG S 6° W 37[±] FEET),

2) A FIR 14 INCH DIAMETER NOW A 6 FOOT-HIGH STUMP 22 INCH DIAMETER

WITH WELL HEALED BLAZE BEARS N 88 3/4° W 27[±] FEET.

00 (T24-3) ⁴
161 (T24-4) ⁴

RENEWAL


Monument Set: (Procedure and Description) NONE

New Accessories: (Description) 1) A HEMLOCK 5 INCH DIA. BEARS N7°W
50² FEET BLAZED AN "X" ON TREE TRUNK, BLAZE AND SCRIBE
"BT" NEAR BASE.

2) SET A RAILROAD SPIKE IN OUTER PITCH PITCH RING OF A
46 INCH DIAMETER FIR STUMP, 2 FOOT HIGH. SPIKE STAMPED
"B0" BEARS S 35 1/2° W 66^B FEET.

Location and Comments: 19° EAST Compass Declination
CORNER LIES ON A DUG Co. SURV. OFF. Agency
STEEP NORTH SLOPE, LARRY MONREAN DEP. Party Chief
Jerry M. M... Notekeeper
IN LOGGED UNIT
600 FT² SOUTH OF CUT LINE CORNER.
CUTTING LINE

TR. FLOURE Witnesses

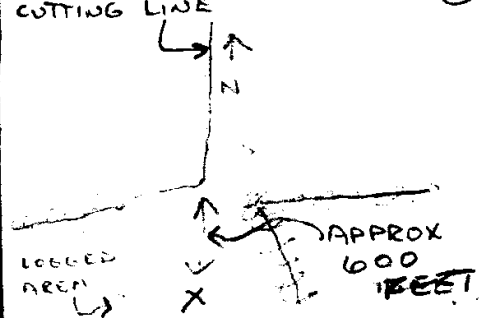

[Handwritten signature]