


DATE: Nov. 23, 1981

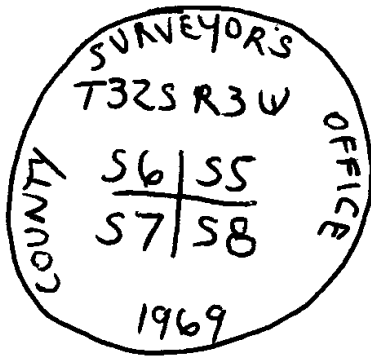

- Condition Report Only
- Not Found
- Renewed
- Unrecorded
- Surveyed In
- Referenced Out

Previous Renewal #'s 10, 102

Monument(s) Found: (Condition and Source) _____

1" I.P., FIRMLY SET, PROJECTING 12" ABOVE GROUND
WITH BRASS CAP MARKED AS ABOVE, SET BY
JOHN POWELL, DOUGLAS COUNTY SURVEYOR'S
OFFICE, IN 1969. 1 1/4" I.P. ALONGSIDE.

Accessories Found: (Condition and Source) ORIGINAL BTS:

A ✓ ROOTHOLE, S22 1/2° E, 27⁰ FT. WITH 35" D. FIR LOG
ALONGSIDE, WITH SCRIBE MARKS VISIBLE ON DOUBLE
BARK BLAZE.

A ✓ ROOTHOLE, S10° W, 27⁷ FT., WITH 25" D. FIR LOG
ALONGSIDE, WITH HEALED DOUBLE BLAZE.

A ✓ 20" D. FIR, N54° 45' W, 9³ FT., WITH HEALED

#212 (T32-3) ✓

DOUBLE BLAZE.

AND BT MARKED BY WENDEROTH IN 1950:

A 17" HEMLOCK, N36 $\frac{1}{2}$ °E, 12 $\frac{1}{4}$ FT., WITH HEALED
DOUBLE BLAZE.

RENEWAL

Monument Set: (Procedure and Description) _____

New Accessories: (Description) _____

I SCRIBE NEW BT:

A 15" V. FIR, S39 $\frac{1}{2}$ °E, 52° FT., MARKED

" T32SR3W S8 CS BT " ON DOUBLE BLAZE.

Location and Comments:

18 $\frac{1}{2}$ °E

Compass Declination

U. S. F. S.

Agency

CORNER LIES ON

LEONARD HERZSTEIN

Party Chief

E. SLOPE, ABOUT

Notekeeper

100 FT. WEST

RANDY LOPEZ

Witnesses

AND 150 FT. SOUTH

JIM HAMILTON

OF SNOW CREEK RD.

OK phl