


DATE: NOV. 25, 1981

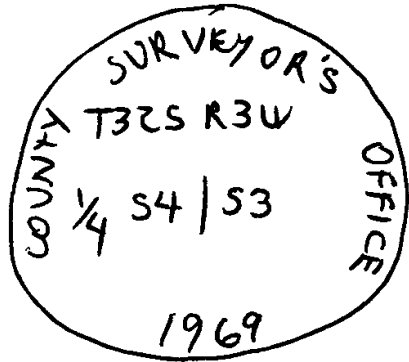

- Condition Report Only
- Not Found
- Renewed
- Unrecorded
- Surveyed In
- Referenced Out

Previous Renewal #'s 12, 86

Monument(s) Found: (Condition and Source) _____

1 1/4" I.P., FIRMLY SET, PROJECTING 14" ABOVE
GROUND, WITH BRASS CAP MARKED AS ABOVE,
SET IN 1969 BY JOHN POWELL, DOUGLAS COUNTY
SURVEYOR'S OFFICE. 1" I.P. ALONGSIDE.

Accessories Found: (Condition and Source) _____

BT MARKED BY WENDEROTH IN 1947:
A 7" YEWWOOD, S44°W, 54⁰ FT., WITH SCRIBE MARKS
" 1/4 S4 CS BT" VISIBLE ON PARTY HEADED
DOUBLE BLAZE.

AND BT MARKED BY POWELL IN 1969:
A 46" D. FIR, SISE, 19⁶ FT., WITH SCRIBE MARKS

211 (T32-3) ✓

"1/4 53 CS BT" VISIBLE ON ~~PA~~ PARTLY
HEALED BLAZE.

RENEWAL

Monument Set: (Procedure and Description) _____

New Accessories: (Description) _____

Location and Comments:	<u>U.S.F.S.</u>	Compass Declination
FENCE CORNER	<u>LEONARD HEARSTEIN</u>	Agency
BEARS N71°E, 16° FT	<u>RANDY</u>	Party Chief
WITH FENCE RUNNING	<u>J. LOPEZ</u>	Notekeeper
SOUTH & WEST.	<u>JIM HAMILTON</u>	Witnesses
CORNER IS ABOUT	_____	
100 FT. NW OF DIRT ROAD.		

OK
[Signature]