

GOVERNMENT CORNER RESTORATION FORM

Township 24S Range 2W Sec. 14 County DOUGLAS

State OREGON Date 12-8-81 No. _____

Corner Designation

$\frac{1}{4}$ T 24S
15 | 14
R 2W

- Condition Report Only
- Not Found
- Renewed
- Unrecorded
- Surveyed In
- Referenced Out

Previous Renewals REN. #6 - REF. CS 59/30

Monument(s) Found: (Condition and Source)

FD. 1 1/2" x 30" I. PIPE PER REN. #6
LYING ON TOP OF 58" FIR STUMP
MENTIONED IN CS 59/30.

MONUMENT DETAIL

Accessories Found:

- ① FD. ORIG. 36" NOW 38" HEMLOCK
STUMP WITH SCRIBED "1/4 S" VISIBLE ON EXPOSED FACE.
(REC. PER CS 59/30 - S18°E 152 TO FACE)
- ② FD. 12" NOW 15" HEMLOCK WITH ILLEGIBLE SCRIBING VISIBLE ON
PARTIALLY HEALED FACE. (REC. PER CS 59/30 N86°E 532)
- ③ FD. PK NAIL IN NOTCH IN THE SIDE OF 34" FIR STUMP.
(REC. PER CS 59/30 S23E-352)
- ④ FD. PK NAIL IN TOP OF 58" FIR STUMP.
(REC. PER CS 59/30 N64°W 372)
- ⑤ FD. PK NAIL IN ROOT OF 36" HEMLOCK STUMP. DUE TO
ROAD CONST. THIS TREE IS NO LONGER VISIBLE FROM
COR. LOCATION.
- ⑥ 38" HEMLOCK SNAG PER CS 59/30 WAS DESTROYED BY
ROAD CONST.

#113 ✓

C.S. File No. 61/29-41 C

Monument Set (Procedure and Description)

Monument Detail

USING PK NAIL IN TOP OF 58" FIR STUMP, I RESET 1 1/2" x 30" IP 12" BELOW SURFACE OF ROAD IN RD. SHOULDER. IP BEARS S 69° E 37 1/2' FROM PK NAIL. I CHECK THIS POSITION USING PK NAIL IN 34" FIR STUMP, ORIG. 38" HEMLOCK STUMP & 12" NOW 15" HEMLOCK BT. BEARING & DIST'S. MATCH RECORD FOR ALL THREE BT'S.

ALSO I SET 1" x 30" IP WITH BRASS CAP (MARKED AS SHOWN ON RIGHT) 50 FT WEST OF 1/4 COR FOR WIT. COR. BRASS CAP PROTRUDES 10" OUT OF GROUND.

DOUGLAS WIT. CO. SURVEYOR
 50 FT. EAST
 TO
 1/4 S1S | S14
 T 24'S R
 Z
 W
 1981

New Accessories TO WIT. COR.


9" HEMLOCK SCRIBED "X CS BT" IN DOUBLE BLAZE BEARS N 9° W 45 1/2'.

10" HEMLOCK SCRIBED "X CS BT" IN DOUBLE BLAZE BEARS N 1° E 33 1/2'.

PK NAIL IN 58" FIR STUMP (PER CS 59/30) BEARS N 44° E 23 1/2'.

Sketch of Monument, Accessories, and General Area

Location & Comments

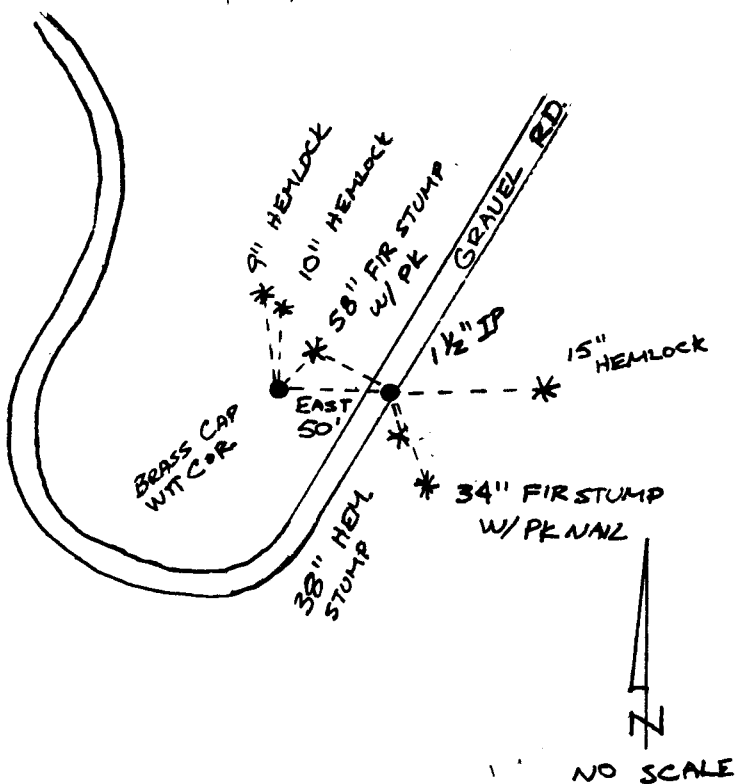

Comp. Declin. 19° E
 Agency DCSO
 Party Chief Gregory E. Ziebell
 Notekeeper GREG DUBELL
 Witnesses DEBBIE STEWART

[Handwritten signature]

Surveyor's Seal

NO SCALE

15 | 14 T24S R2W

1/4

(SEE REV. # 6)

FOUND:

A 1 1/2" I. PIPE, SET ALONG THE EASTERLY EDGE OF A FIRE TRAIL, EXTENDING 18" ABOVE GROUND, AS SET BY HOSFORD (REV. # 6)

FROM WHICH

THE ONLY REMAINING ORIGINAL BEARING TREE, AN ORIG. 36" HEMLOCK, NOW A 38" STUMP BEARING S 18° E 16 1/2 FT. (REV. S 18° E 15 1/2 FT. MEASURED TO FACE) WITH SCRIBING "1/4 S" VISIBLE ON EXPOSED FACE.

AND TREES MARKED BY HOSFORD:

AN 11" NOW 12" HEMLOCK WITH ~~SCR~~ ILLEGIBLE SCRIBING VISIBLE ON PARTIALLY HEALED FACE, ALIVE AND IN GOOD CONDITION BEARS N 86° E 53 1/2 FT.

DIETZSEN NO. 385-6

✓
77

OBT SE

$18^{\circ} @ 26^{\circ} (= 16^{\frac{1}{2}})$

NGW NERT

$56^{\circ} @ 17^{\frac{1}{2}} = 53^{\frac{1}{2}} \text{ FT}$

12" HEMLOCK

BD

$79^{\circ} @ 11^{\frac{1}{2}} = 77^{\frac{1}{2}} \text{ LVL}$

N 17° W

PK NAIL SET IN ROOT OF 36" HEMLOCK TREE

$39^{\frac{1}{2}} @ 25^{\frac{1}{2}} = 35^{\frac{6}{11}}$

S 23° E

PK NAIL SET IN NOTCH IN SIDE OF 34" FIR
STUMP

37 6 LVL

N 64° W

PK SET IN TOP OF ~~30~~ 30" FIR STUMP
58

AND A 36" HEMLOCK NOW A 38" SNAG, WITH
SCRIBING "S 15 253 BT" VISIBLE ON
UNHEALED BLAZE BEARS $S 62^{\circ} W$ 59 $\frac{1}{2}$ FT.,
(REC. $S 62^{\circ} W$ 58 $\frac{1}{2}$ FT.).

DUE TO FUTURE ROAD CONSTRUCTION IN THE
AREA, WE REFERENCE THIS CORNER
LOCATION AS FOLLOWS:

A "PK" NAIL SET IN THE ROOT OF A 36"
HEMLOCK BEARS $N 17^{\circ} W$ 77 $\frac{1}{2}$ FT.

A "PK" NAIL SET IN A NOTCH IN THE SIDE OF
A 34" D. FIR STUMP BEARS $S 23^{\circ} E$
35 $\frac{1}{2}$ FT.

AND A "PK" NAIL SET IN THE TOP OF A 58"
D. FIR STUMP BEARS $N 64^{\circ} W$ 37 $\frac{1}{2}$ FT.

COMPASS DECLINATION SETTING: 20° EAST

1-11-77

Mary J. Langley
A. VICTOR CANGIE

OK *[Signature]*
C. S. File No. ~~59/20~~
61/29-41 Mike Tompkins