


DATE: DEC. 10, 1981

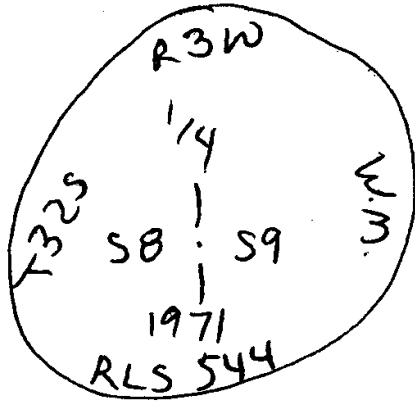

- Condition Report Only
- Not Found
- Renewed
- Unrecorded
- Surveyed In
- Referenced Out

Previous Renewal #'s 154

Monument(s) Found: (Condition and Source) _____

2" I.P., FIRMLY SET, PROJECTING 6" ABOVE GROUND,
WITH BRASS CAP MARKED AS ABOVE, SET IN
1971 BY ~~MALCOLM CLARK~~ DON GARRETT, OREGON LICENSED
SURVEYOR # 544.

Accessories Found: (Condition and Source) _____

BTS. MARKED BY GARRETT IN 1971:
A 14" D. FIR, EAST, 4 1/4 FT., WITH
HEALED BLAZE.
A 8" CHINQUAPIN, N45°W, 12 1/2 FT., WITH
SCRIBE MARKS "1/4 SB BT" VISIBLE ON
PARTLY HEALED BLAZE.



RENEWAL

Monument Set: (Procedure and Description) _____

New Accessories: (Description) _____

Location and Comments:

U.S.F.S.
LEONARD HERSTEIN
JIM LANDRUM
JIM HAMLTON

Compass Declination
Agency
Party Chief
Notekeeper
Witnesses

OK *[Signature]*