

GOVERNMENT CORNER RESTORATION FORM

Township 31 S Range 3 W Sec. 30 County DOUGLAS

State OREGON Date 12-29-81 No. \_\_\_\_\_

Corner Designation

1/4 S 30  
S 31

- Condition Report Only
- Not Found
- Renewed
- Unrecorded
- Surveyed In
- Referenced Out

Previous Renewals # 20 (SEE CS 39/74-M 27-14) C# 153

Monument(s) Found: (Condition and Source)

ORIGINAL MONUMENT NOT FOUND

NOTE: INSPECTION OF THE MAP IN COUNTY SURVEYOR'S FILE M 27-14 SHOWING THE METHOD BY WHICH THE FOLLOWING MONUMENTS WERE SET INDICATES THAT THE PROPORTIONING PROCEDURE AS DEFINED BY THE BLM SURVEYING MANUAL WAS NOT USED, THE MONUMENTS ARE NOT AT THE MOST PROBABLY PROBABLE POSITION OF THE QUARTER CORNER. DUE TO THEIR LONG STANDING AND USE IN THE AREA IT IS NECESSARY TO LEAVE THE EVIDENCE FOUND FOR FUTURE SURVEY NEEDS:

- 1- REV. #20 A 1" DIAM. IRON PIPE
- 2- REV #153 A 1" DIAM. IRON PIPE WITH AN ATTACHED BRASS CAP, CAP IS STAMPED AS NOTED IRON PIPE IS ALONG WESTERLY SIDE OF BRASS CAP MONUMENT.

Accessories Found:

TREES FROM RENEWAL # 153

- 1- A MADRONE 12 NOW 14 INCH DIAM. WITH WELL HEALED DOUBLE BLAZE BEARS S 41° E 28 1/2 FEET (REC. S 38 1/2° E 28 1/2 FEET TAG ON TREE NOTES DISTANCE AS 28 1/2 FEET)
- 2- A D. FIR 13 NOW 15 INCH DIAM WITH WELL HEALED DOUBLE BLAZE BEARS N 37 1/2° E 65 FEET (REC. N 35 1/2°)

MONUMENT DETAIL

COUNTY SURVEYORS OFFICE  
T 31 S R 3 W

1/4 S 30  
S 31  
1966

RENEWAL

Monument Set (Procedure and Description)


Monument Detail

NONE

New Accessories

NONE

Sketch of Monument, Accessories, and General Area

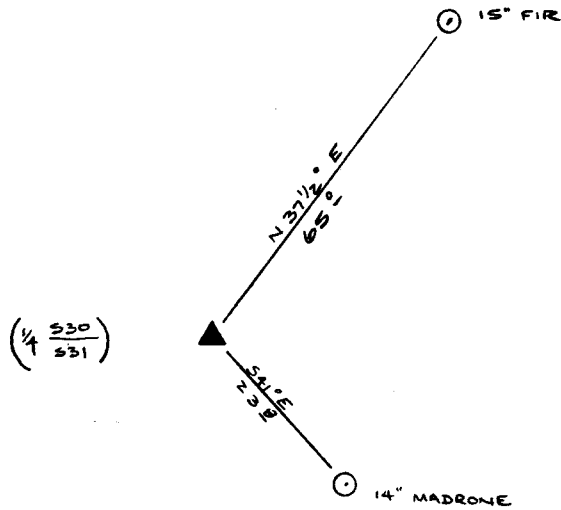

Location & Comments

Comp. Declin. 19° EAST

Agency DOUG. CO. SURV. OFF.

Party Chief LARRY E. MONTEAN

Notekeeper James J. Morrow DEPUTY

Witnesses J.M. DANIEL

T.L. BUCKY

Surveyor's Seal