

GOVERNMENT CORNER RESTORATION FORM

Township 31 S Range 34 W Sec.

25	30
26	31

 County DOUGLAS
 State OREGON Date 12-30-81 No. _____

Corner Designation

R	T 31 S	R
4	S 25 S 30	3
W	S 36 S 31	W

____ Condition Report Only
 ____ Not Found
 Renewed
 ____ Unrecorded
 ____ Surveyed In
 ____ Referenced Out

Previous Renewals # 19, 141

Monument(s) Found: (Condition and Source)

ORIGINAL STONE MONUMENT & POST CORNER MONUMENTS NOT FOUND. ALSO NOT FOUND WENDERTH 1 INCH DIAM. IRON PIPE.

FOUND FROM REN. NO. 141 1" X 36" IRON PIPE WITH ATTACHED BRASS CAP STAMPED AS NOTED. MONUMENT IS LYING ON ITS SIDE IN FILL AREA.

NOTE THE ORIGINAL GROUND IN THIS AREA IS COVERED WITH DEBRIS FROM ROAD FILL.

MONUMENT DETAIL

COUNTY SURVEYORS OFFICE

	T 31 S	
R	S 25 S 30	R
4	S 36 S 31	3
W		W
	1966	

Accessories Found:

AS THE ORIGINAL BEARING TREE CALLS DO NOT FIT WELL, A DISTANCE INTERSECT IS USED TO DETERMINE THE POSITION FROM WHICH THE FOLLOWING MEASUREMENTS WERE MADE

- 1- ORIGINAL FIR 12 NOW 27 INCH DIAM BEARS N 9° W 19± FEET (REC. N 25° W). BLAZE IS WELL HEALED WE OPEN AND FIND SCRIBING "S 25 R 4".
- 2- FROM ORIGINAL SURVEY RENEWAL OF CORNER A 20 NOW 30 INCH DIAM FIR WITH WELL HEALED BLAZE BEARS N 16° E 22± FEET, WE OPEN BLAZE AND FIND SCRIBING "W 3"
- 3- THE 26½ INCH CEDAR, A SNAG DURING RENEWAL #141, IS NOW DOWN WITH SOME SCRIBE MARKS VISIBLE ON UNHEALED FACE. THE RECORD BEARING AND DISTANCE (~~S 26½°~~ S 12¼° W 21± FEET) FALLS ON THE ROOT WAD OF THE BT.
- 4- DW. #19 A FIR 18" NOW A STUMP (SIZE INDETERMINATE) WITH FRAGMENTARY SCRIBING VISIBLE BEARS S 22° E 48± FT. (REC S 19° 12' E 47.5 FEET)
- TREES FROM REN. #141
- 5- A D. FIR 19 NOW 21 INCH DIAM WITH WELL HEALED DOUBLE BLAZE BEARS ~~S 26½° W~~ S 16° E 20± FEET (REC. S 16° E 20± FT)
- 6- A D FIR B NOW 14 INCH DIAM. WITH WELL HEALED DOUBLE BLAZE BEARS S 86° W 17± FEET (REC S 83° W 17± FT)
- 7- NOT OF RECORD A D. FIR 22 INCH DIAM BEARS NORTH 23± FEET, HAS YELLOW TAG MARKED "31 S 3 W KB 8/20/39"

245 T31-3 ✓
 # 172 T31-4 ✓

G.S. File No. 161/30-5

C

RENEWAL

Monument Set (Procedure and Description)

Monument Detail


FOUND MONUMENT IS SET AT POSITION AS DETERMINED BY PREVIOUS NOTE.

NA

New Accessories

NONE

Sketch of Monument, Accessories, and General Area

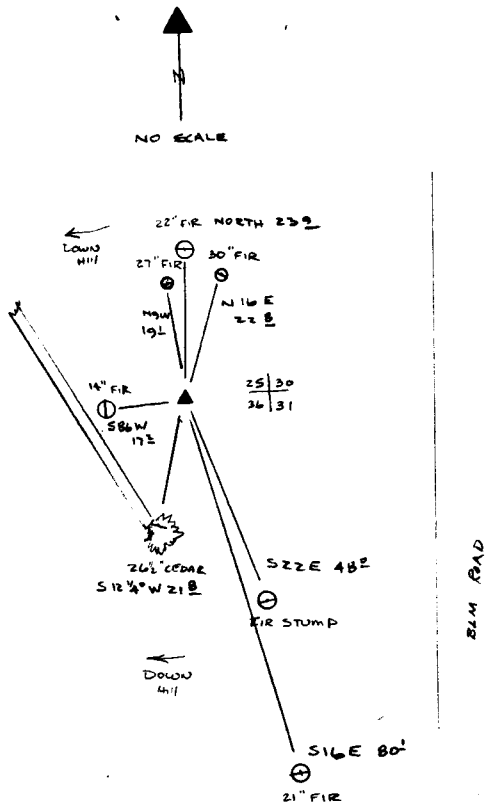

Location & Comments

Comp. Declin. 19° EAST
 Agency Douglas County Surveyors Office
 Party Chief LARRY E. MONBEAN
 Notekeeper Jerry T. Moore DEPUTY
 Witnesses J.M. POWELL

SK [Signature]

Surveyor's Seal