

GOVERNMENT CORNER RESTORATION FORM

Township 24S Range 1W Sec. 16 County DOUGLAS

State OR. Date 1-13-82 No. _____

Corner Designation

T 24S R7W

17 | 16
20 | 21

Condition Report Only
 Not Found
 Renewed
 Unrecorded
 Surveyed In
 Referenced Out

MONUMENT DETAIL

Previous Renewals #13, #57, 1976 RESURVEY

Monument(s) Found: (Condition and Source)

FD. 1976 BLM BRASS CAP MARKED AS PER
DETAIL ON RIGHT, BURIED 18" IN GROUND.

FD. 1" SHAFT WITH 2 1/2" DIA. FLAT TOP ALONG
NW EDGE OF BLM BRASS CAP, BURIED
16" IN THE GROUND. THIS MON. IS POSSIBLY
FREARS AXLE PER REN. #13, ALTHOUGH SIZE
IS DIFFERENT.

T 24S R7W

S17 | S16
S20 | S21
1976

Accessories Found:

NO ORIG. BT'S WERE FOUND.

FD. 8" NOW 15" OAK PER REN. #13 WITH FRAGMENTARY SCRIBING VISIBLE
IN PREVIOUSLY OPENED BLAZE BEARS N54W 374 FT.

FD. 26" NOW 28" OAK PER REN. #57 WITH FRAGMENTARY SCRIBING VISIBLE
ON PARTIALLY OPEN BLAZE, BEARS N5E 1274 (REG. 1258)

FD. 1976 BLM BRASS CAP MARKED "T24S R7W S17 RM 1976
BEARS N10W 312,

#1414

Monument Set (Procedure and Description)

Monument Detail


SINCE BLM BRASS CAP IS BURIED DEEP IN THE GROUND ALONG RIVER BANK, I SET 1"X30" IP WITH BRASS CAP MARKED AS PER DETAIL ON RT DIRECTLY OVER BLM CAP. NEW BRASS CAP PROTRUDES 12" OUT OF GROUND-

DOUGLAS CO. SURVEYOR
 T 24 S
 S17 | S16 R
 S20 | S21 7
 W
 ALSO
 M.C.
 1982

New Accessories

11" MYRTLE SCRIBED "T24S R7W S17 CS BT" IN DOUBLE BLAZE BEARS N62W 31°
 9" ASH SCRIBED "T24S R7W S16 CS BT" IN DOUBLE BLAZE BEARS N73E 26°

Sketch of Monument, Accessories, and General Area

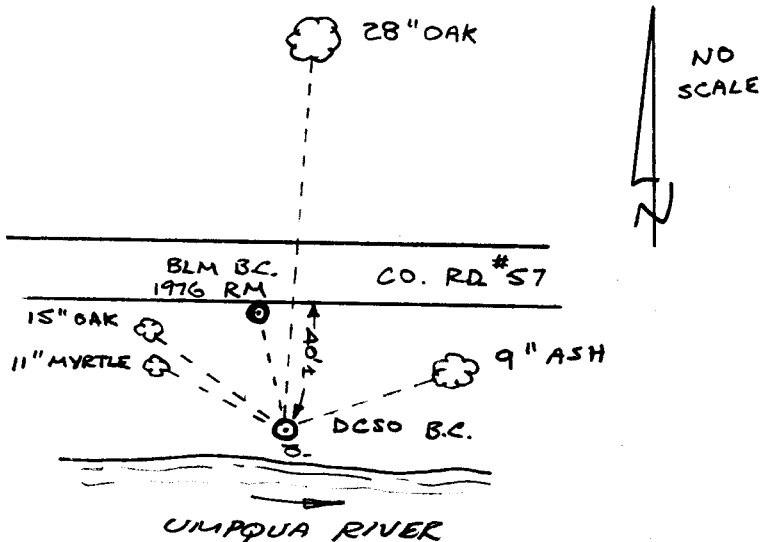

Location & Comments

COR. IS TIED TO STATE PLANE COORD. SYSTEM

Comp. Declin. 19° E
 Agency DCSO
 Party Chief GREG QUIBELL
 Notekeeper Gregory E. Quibell
 Witnesses JOHN POWELL
 RANDY SMITH

Surveyor's Seal