

GOVERNMENT CORNER RESTORATION FORM

Township Z1S Range 9 W Sec. 6 County DOUGLAS

State OREGON Date 1-25-82 No. \_\_\_\_\_

Corner Designation

CC | S6  
| S7

- \_\_\_\_\_ Condition Report Only
- \_\_\_\_\_ Not Found
- Renewed
- \_\_\_\_\_ Unrecorded
- \_\_\_\_\_ Surveyed In
- \_\_\_\_\_ Referenced Out

Previous Renewals ORIGINAL, 1919 & 1966 RESURVEYS

Monument(s) Found: (Condition and Source)

A 1 3/4" DIAM. IRON PIPE, FIRMLY SET, FILLED WITH CONCRETE AND RUSTED OFF 4 INCHES ABOVE GROUND. UPPER PORTION OF PIPE WITH BRASS CAP HAS BEEN PLACED ALONGSIDE LOWER PORTION CAP IS A U.S. GENERAL LAND OFFICE MONUMENT STAMPED AS NOTED.

MONUMENT DETAIL

T Z1 S

CC | S6  
| S7

R10W R9W  
1918

Accessories Found:

ORIGINALS

1- A FIR 65 INS. NOW A 69 INCH DIA. STUMP WITH WELL HEALED BLAZE BEARS N 35 1/2° E 69 ± FEET (REC. N 27° E 71 ± FEET).

2- A FIR 67 INS DIA. NOW A STUMP WITH VISIBLE BURL BEARS S 52° E 118 ± FEET (REC. 101° FEET)

BT'S PER RESURVEY IN 1966

3- A FIR 20 INCHES NOW A 24 INCH DIA. STUMP WITH WELL HEALED BLAZE BEARS N 85° E 27 ± FEET.

4- A CEDAR 6 INCHES NOW A 10 INCH DIA. STUMP WITH UNHEALED BLAZE SCRIBED "T Z1S R9W S7 CC BT" BEARS S 86° E 48 ± FEET (REC 51 ± FEET).

T21-9 4  
T24-10 X

G.S. File No. 61/30-12

RENEWAL

Monument Set (Procedure and Description)

A 1' X 20' GALVANIZED IRON PIPE WITH BRASS CAP ATTACHED IS SET AT POSITION OF FOUND MONUMENT, WITH LOWER PORTION OF FOUND MONUMENT ALONG NORTHERLY SIDE. THE NEW CAP IS STAMPED AS NOTED

Monument Detail

DOUGLAS COUNTY SURVEYOR

T 21 S


R		R
10	CC   56	9
	57	W

1982

New Accessories

AS THERE ARE NO TREES AVAILABLE TO SCRIBE WE SET A RAILROAD SPIKE IN THE RICH RING OF A 24 INCH DIAM. FIR STUMP. SPIKE IS STAMPED "BO" AND BEARS S 55 1/2° E 53 1/2 FEET.

Sketch of Monument, Accessories, and General Area

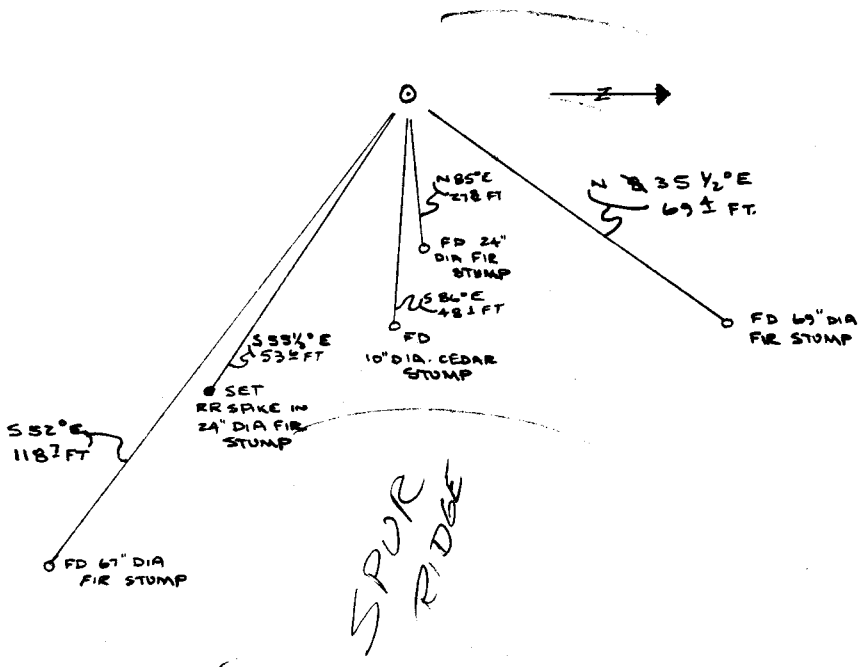

Location & Comments

THIS CORNER LIES ON SOUTH SIDE OF A SPUR RIDGE SLOPING WESTERLY

Comp. Declin. 19° EAST  
 Agency DOUGLAS CO. SURV. OFF.  
 Party Chief MARY E. MURPHY  
 Notekeeper Kathy E. M... DEPUTY  
 Witnesses J. M. POWELL  
R. L. SMITH

OK *[Signature]*

Surveyor's Seal