

GOVERNMENT CORNER RESTORATION FORM

Township 32 S Range 8 W Sec. 20 County Douglas

State ORE. Date 3-16-82. No. _____

Corner Designation

South $\frac{1}{4}$ corner of section 20

- _____ Condition Report Only
- _____ Not Found
- _____ Renewed
- Unrecorded
- Surveyed In
- Referenced Out

Previous Renewals

MONUMENT DETAIL

Monument(s) Found: (Condition and Source)

$\frac{3}{8}$ " Iron Rod set by
Gorden Caster (BLM Cadastral)?

IN A PHONE CONVERSATION BETWEEN
MYSELF AND GORDEN CASTER (BLM
SURVEYOR FROM MEDFORD DIST.), I WAS
TOLD THAT THE $5/8$ " IR WAS SET
AT MIDPOINT ON THE SECTION
LINE IN CONJUNCTION WITH AN
ADMINISTRATIVE SURVEY AND THAT
IT IS NOT AN OFFICIAL COR.

Gregory C. Philbeck
DOUGLAS CO SURVEYORS OFFICE

Accessories Found:

7" D. F. V S89 W 26° (Not scribed) Tagged

10" Medyore N36 E 15° (Not scribed) Tagged

#110+

CSM 6/30/82

Found (Not Recorded)

20
29

T 325 RBW

This cor possibly set by "Gordy 1979"

5/8" IR Rod set for 1/4 cor.

7" D.F.T 589W 26°
Tagged but not scribed


10" Madrone N36E 15°
Tagged but not scribed

(? cor set by Theodolite + EDM)

This point referenced out due to
new Road STA. PL-36+30

DIETZEN NO. 385-B

5/8" IR FD.

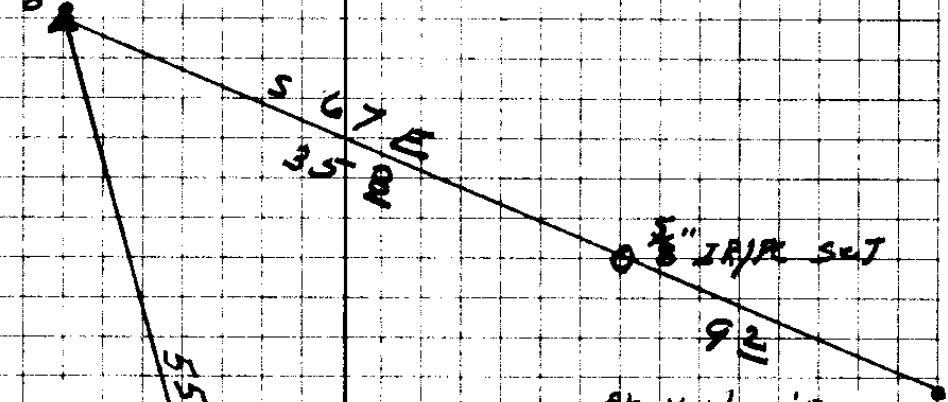

PK Nail in
21" D.F.T

PK Nail in 11" Madrone

over

C & E No. 61/30-17

As in 1968 I found no
evidence of orig cor.

3-16-82

JML

573