

GOVERNMENT CORNER RESTORATION FORM

Township 20 S Range 10 W Sec. 32 County DOUGLAS

State OR Date 3-22-82 No. \_\_\_\_\_

Corner Designation

T20S  
 S32 | S33 R  
 S5 | S4 W  
 T21S

- \_\_\_\_\_ Condition Report Only
- \_\_\_\_\_ Not Found
- Renewed
- \_\_\_\_\_ Unrecorded
- \_\_\_\_\_ Surveyed In
- \_\_\_\_\_ Referenced Out

Previous Renewals #1 - #58(21-10)

Monument(s) Found: (Condition and Source)

FD. 2" IRON PIPE FILLED WITH CONC.  
FIRMLY SET PROTRUDING 6" OUT OF GROUND.  
THE TOP 10" OF SAID IP HAS BRASS  
CAP ATTACHED AND IS BROKEN OFF  
AND LYING ON GROUND. THE BRASS  
CAP IS AN UNRECORDED GLO CAP STAMPED  
AS PER DETAIL ON RIGHT AND ALSO  
MENTIONED IN REN. #1.

ALSO FD. UNRECORDED 20" x 5"  
PLOW SHEAR ALONG SIDE IRON PIPE.

GENERAL LAND OFFICE SURVEY

T20S  
 R10W  
 S E2 | S33  
 S5 | S4  
 T21S

1918

Accessories Found:

FD. 14" ALDER PER REN. #1 WITH POSSIBLE WELL HEALED BLAZE &  
NEWLY BARK SCRIBED "S 5 BT", BEARS S 63° W 42 FT. (REC. 52)  
BARK SCRIBING PER REN. #58 (T21S R10W)

FD. 15" NOW 20" FIR STUMP PER REN. #1 WITH SCRIBED "BT" VISIBLE  
BEARS N 32° E 28<sup>±</sup> FT (REC. N 45° 30' E 29<sup>±</sup> FT.)

FD. 12" NOW 15" FIR SNAG APPROX. 40 FT. TALL WITH WELL HEALED  
BLAZE BEARS N 30° E 23<sup>±</sup> FT.

12" ALDER PER REN. #1 IS GONE AS IS ANY ORIG. EVIDENCE.

# 72 T20-10 X  
 # 60 T21-10 X

RENEWAL

Monument Set (Procedure and Description)

AT THE LOCATION OF THE 2" IP FILLED WITH CONC. I SET A 1"x30" IP WITH BRASS CAP ATTACHED, MARKED AS PER DETAIL ON RT. I BURIED BOTH PARTS OF FD. GLO IP & BRASS CAP ALONG WITH PLOW SHEAR ALONG SIDE NEW BRASS CAP.

Monument Detail

DOUGLAS  
 T205  
 S32 | S33  
 S5 | S4  
 T215  
 1982  
 RION  
 SURVEYOR


New Accessories

16" FIR SCRIBED "T205 R10W S33 CS BT" IN DOUBLE BLAZE BEARS N2°E 83<sup>8</sup> FT.

7" FIR SCRIBED "T215 R10W S4 CS BT" IN DOUBLE BLAZE BEARS S1°E 16<sup>2</sup> FT.

24" CEDAR SCRIBED "T215 R10W S5 CS BT" IN DOUBLE BLAZE BEARS S71°W 32<sup>9</sup> FT.

Sketch of Monument, Accessories, and General Area

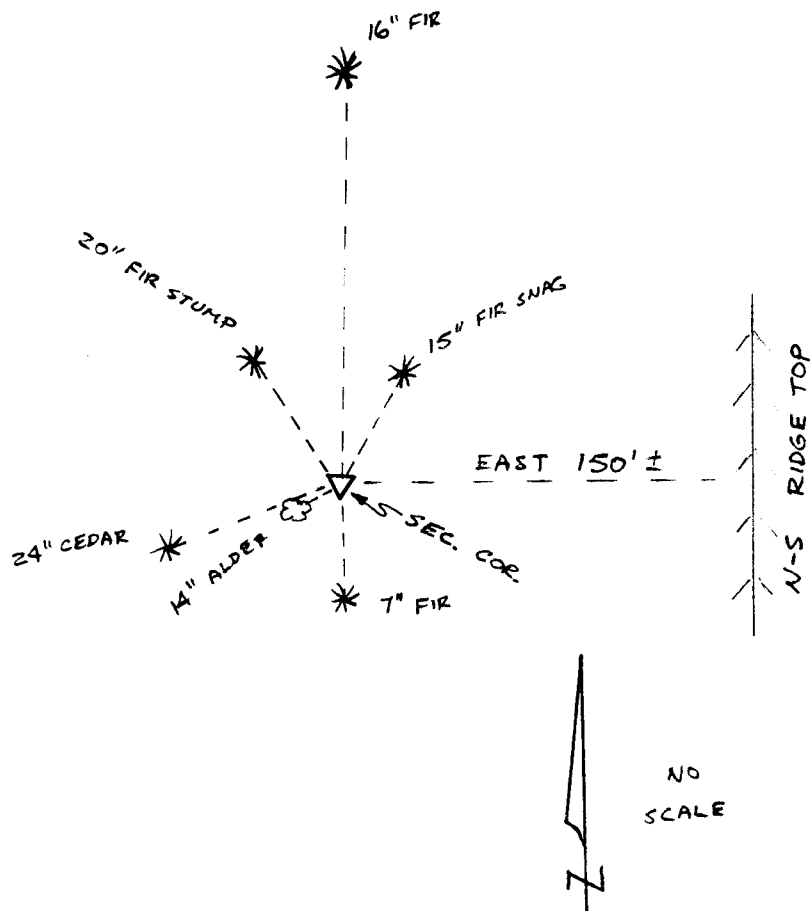

Location & Comments

Comp. Declin. 19° E  
 Agency DCSO  
 Party Chief GREGORY E. QUIBELL  
 Notekeeper Gregory E. Quibell  
 Witnesses RANDY SMITH

Surveyor's Seal

- REGISTERED  
 PROFESSIONAL  
 LAND SURVEYOR

*Gregory E. Quibell*

OREGON  
 JULY 13, 1979  
 GREGORY E. QUIBELL  
 1884

2" IRON PIPE FILLED WITH  
CONC. WITH BRASS CAP  
STAMPED:  
GENERAL LAND OFFICE SURVEY

T 20 S  
R 10 W

SE 2 | S 33

S 5 | S 4

T 21 S

1918



ALSO FD, 20"x5"  
PLOW SHEAR BURIED  
ALONG SIDE.