

GOVERNMENT CORNER RESTORATION FORM

Township 29S Range 4W Sec. 7 County DOUGLAS

State OR Date 4-5-82 No. _____

Corner Designation

$\frac{1}{4}$ COR 6
T29S RAW 7

- _____ Condition Report Only
- _____ Not Found
- Renewed
- _____ Unrecorded
- _____ Surveyed In
- _____ Referenced Out

Previous Renewals #141, #183

Monument(s) Found: (Condition and Source)

FD. $\frac{1}{2}$ " IP PER REN. #141 SET FLUSH WITH THE GROUND ALONG THE SOUTH EDGE OF $1\frac{1}{2}$ " TP WITH BRASS CAP ATTACHED PER REN. #183 SAID BRASS CAP IS FIRMLY SET AND PROTRUDES APPROX. 10" OUT OF GROUND. BRASS CAP IS MARKED AS PER DETAIL ON RIGHT.

COUNTY SURVEYORS OFFICE
 T29S
 $\frac{1}{4}$ 56
57
 RAW
 1963

Accessories Found:

FD. ORIG. 10" FIR, NOW 26" STUMP BEARS S60°W 17 $\frac{3}{4}$ " (REC. 16 $\frac{3}{4}$) I FIND BUTT SECTION OF TREE ALONGSIDE STUMP WITH SCRIBED "1/4S" VISIBLE ON AN OPENED FACE (THIS PIECE IS ROTTING BADLY)

FD. 20" NOW 27" MADRONE PER REN #141 WITH SCRIBED "1/4S / ^ (83 BT" VISIBLE IN AN UNHEALED BLAZE, BEARS S40°E 19 $\frac{3}{4}$ FT (REC DIST. OF 17 $\frac{3}{4}$ FITS WELL TO FACE)

FD. 12" NOW 14" MADRONE PER REN. #141 NOW A WINDFALL BEARS N5°E 21 $\frac{1}{2}$ TO ROOT HOLE. SCRIBED 1/4S6 368 $\frac{1}{2}$ VISIBLE IN UNHEALED BLAZE

#257 X


CS. 61/30-21

C

RENEWAL

Monument Set (Procedure and Description)

Monument Detail

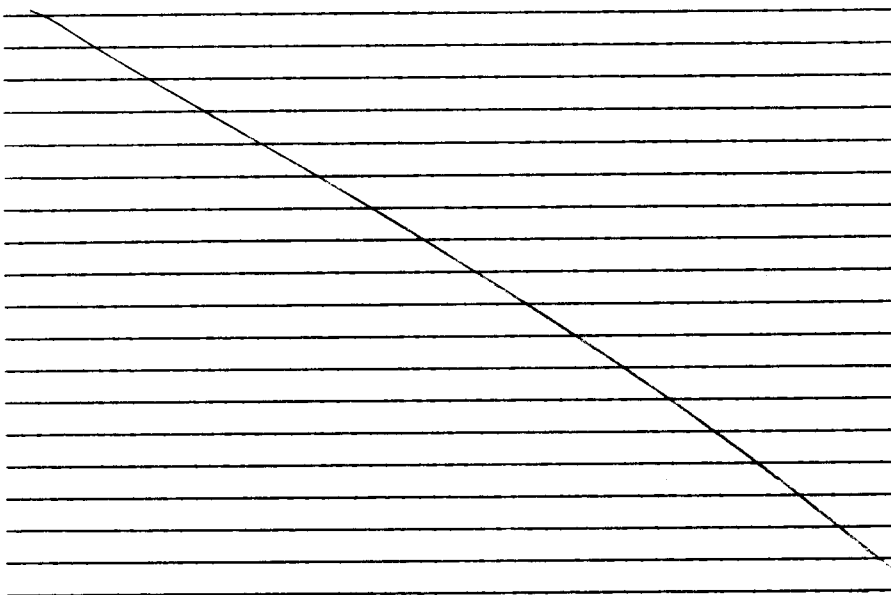


New Accessories

13" FIR SCRIBED "1/4 57 CS BT" IN DOUBLE BLAZE BEARS S 7 W 38 1/2 FT.

16" FIR SCRIBED "1/4 56 CS BT" IN DOUBLE BLAZE BEARS N 83 1/2 E 21 1/2 FT.

14" FIR SCRIBED "1/4 56 CS BT" IN DOUBLE BLAZE BEARS N 3 E 81 FT.

Sketch of Monument, Accessories, and General Area

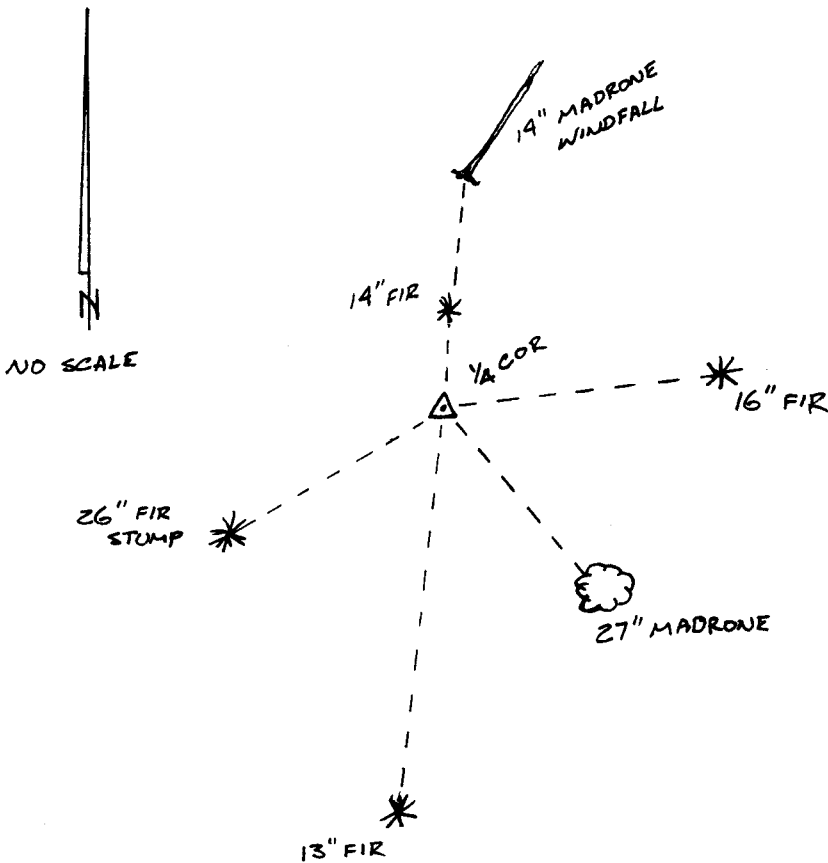

Location & Comments

Comp. Declin. 19° EAST

Agency DCSO

Party Chief GREGORY E. QUIBELL

Notekeeper Gregory E. Quibell

Witnesses JOHN POWELL

KAREN REED

Surveyor's Seal

REGISTERED
PROFESSIONAL
LAND SURVEYOR

Gregory E. Quibell

OREGON
JULY 13, 1979
GREGORY E. QUIBELL
1834