

GOVERNMENT CORNER RESTORATION FORM

Township 31 S Range 2 W Sec. 14 County DOUGLAS

State OR. Date 4-14-82 No. _____

Corner Designation

T 31 S R 2 W
1/4 S 15 | S 14

- Condition Report Only
- Not Found
- Renewed
- Unrecorded
- Surveyed In
- Referenced Out

Previous Renewals #14 & #83

MONUMENT DETAIL

Monument(s) Found: (Condition and Source)

FD. 1/2" IP PER REN. #83 PROTRUDING
18" OUT OF GROUND.

Accessories Found:

FD. 8" NOW 14" CEDAR PER REN. #83 WITH WELL HEALED DOUBLE
BLAZE BEARS S 71° W 8.0 FT.

FD. 9" NOW 13" CEDAR PER REN. #83 WITH WELL HEALED DOUBLE
BLAZE BEARS S 52° E 25.0 FT. (REC. S 54° E)

FD. 18" FIR STUMP PER REN. #83 WITH SCRIBED "BT"
VISIBLE, BEARS N 68 1/2° W 6.0 FT. (REC. 5-3)

#222X

U.S. File No. 61/30-23C

RENEWAL

Monument Set (Procedure and Description)

Monument Detail

AT THE LOCATION OF THE FD.
 1/2" IP I SET A 1" x 30" IP WITH
 BRASS CAP ATTCHED MARKED AS PER
 DETAIL ON RT. I PLACE 1/2" IP
 ALONG SOUTH SIDE OF BRASS CAP.
 DUE TO ROCKY SOIL I SET IP
 WITH BRASS CAP 8" INTO THE GROUND
 AND BUILD A MOUND OF STONE,
 18" TALL, AROUND PIPE.


DOUGLAS
 CO SURVEYOR
 T315
 S15 | S14
 1/4 R2W
 1982

New Accessories

10" FIR SCRIBED " 1/4 S15 CS BT" IN DOUBLE BLAZE BEARS S14°W 15.9 FT.
 13" FIR SCRIBED " 1/4 S14 CS BT" IN DOUBLE BLAZE BEARS N44°E 42.0 FT.

Sketch of Monument, Accessories, and General Area

NO SCALE

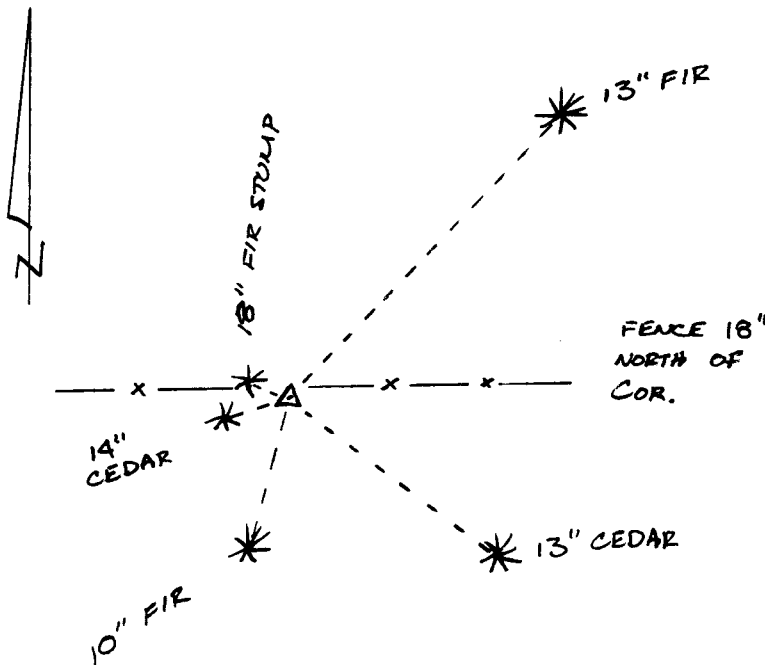

Location & Comments

Comp. Declin. 19° E
 Agency DCSO
 Party Chief GREGORY E. QUIBELL
 Notekeeper Gregory E. Quibell
 Witnesses KAREN REED
JOHN POWELL

Surveyor's Seal

REGISTERED
 PROFESSIONAL
 LAND SURVEYOR

Gregory E. Quibell

OREGON
 JULY 13, 1979
 GREGORY E. QUIBELL
 1834