

GOVERNMENT CORNER RESTORATION FORM

Township 27S Range 8W Sec. 19 County DOUGLAS

State OR. Date 4-29-82 No. _____

Corner Designation T27S R8W

S19	S20
S30	S29

Condition Report Only
 Not Found
 Renewed
 Unrecorded
 Surveyed In
 Referenced Out

Previous Renewals

Monument(s) Found: (Condition and Source)

FD. UNRECORDED 1/2" IP FIRMLY SET
PROTRUDING 3" OUT OF GROUND.

FROM WHICH:

Accessories Found:

FD. ORIG. 48" NOW 53" FIR WITH WELL HEALED DOUBLE BLAZE BEARS N 55° E 58[±]. (REC. 55[±]) DUE TO SEVERAL LARGE WINDFALLS MY DISTANCE WAS TAKEN FROM APPROX. 10 FT ABOVE GROUND AT BOTH ENDS, WHICH COULD ACCOUNT FOR DIFFERENCE NOTED.

FD. ORIG. 24" NOW 30" HEMLOCK WITH SCRIBED "R 8W" VISIBLE IN PARTIALLY HEALED BLAZE BEARS S 41° E 71[±]. (REC. 69[±])

FD. ORIG. 12" NOW 24" HEMLOCK WINDFALL LYING IN APPROX. CORRECT LOCATION. I CAN'T SEE TREE FROM COR. DUE TO SEVERAL LARGE DOWN TREES.

FD. ORIG. 24" HEMLOCK STUMP WITH SCRIBED "27S 8V" VISIBLE IN PARTIALLY HEALED BLAZE, BEARS N 12° W 29[±].

FD. UNRECORDED 4" FIR WITH WEYERHAEUSER "W" NAIL BEARS S 22° E 7[±] FT.

MONUMENT DETAIL

60X

RENEWAL

Monument Set (Procedure and Description)


Monument Detail

AT THE LOCATION OF THE ED. 1/2" IP
 I SET A 1" x 30" IP WITH BRASS CAP
 ATTACHED AND PROTRUDING 10" OUT OF
 GROUND.

DOUG. COUNTY SURVEYORS OFFICE
 T275
 S19 | S20
 S30 | S29
 R8W
 1982

New Accessories

Sketch of Monument, Accessories, and General Area

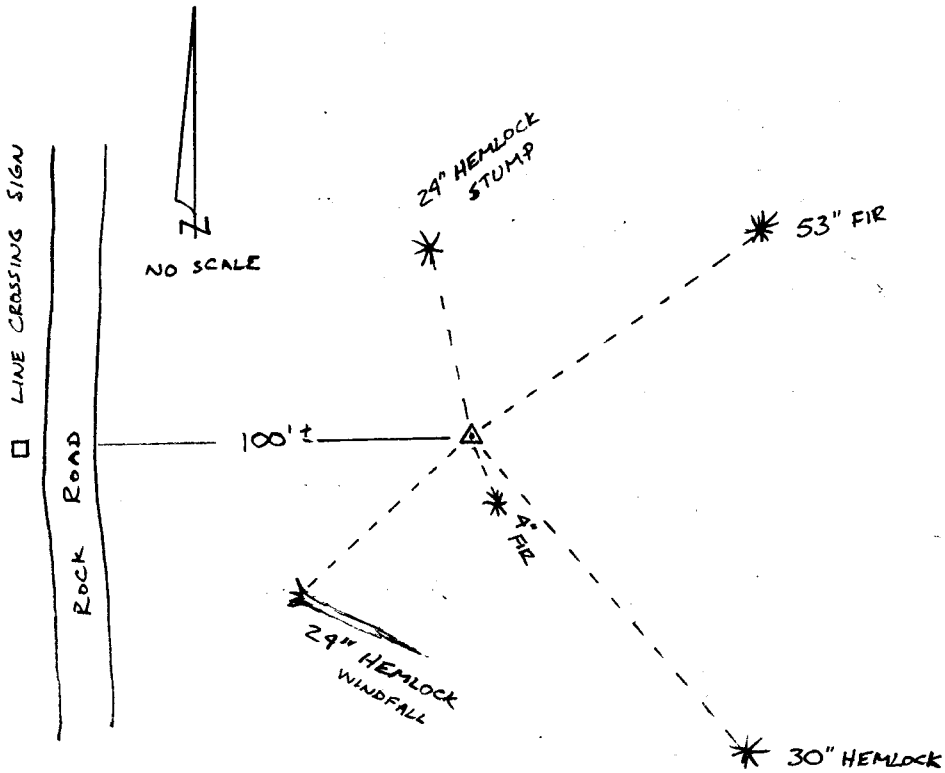

Location & Comments

Comp. Declin. 19° E
 Agency D.C.S.O.
 Party Chief GREGORY E. QUIBELL
 Notekeeper Gregory E. Quibell
 Witnesses TERRY PLOUFFE
JOHN POWELL

OK *flm*

Surveyor's Seal

REGISTERED
 PROFESSIONAL
 LAND SURVEYOR

Gregory E. Quibell

OREGON
 JULY 13, 1979
 GREGORY E. QUIBELL
 1834