

DATE: 4/2/82

Condition Report Onl

Not Found

Renewed

Unrecorded

Surveyed In

Referenced Out

Previous Renewal #'s #20

Monument(s) Found: (Condition and Source) _____

Douglas County brass cap, found $1\frac{1}{2}$ ' below ground surface,

marked T22S R10W M.C. S23 S24 1961

Accessories Found: (Condition and Source) _____

16" Dogwood brs. S62°E, dist. 48.8', healed face

SW Maple BT (triple trunk) - the scribed section of tree found

uprooted and fallen toward river. The second trunk is dead -

remaining trunk is live

#82 ✓

C.E.B. No. 61/33-3

Page 1 of 1

C

RENEWAL

Monument Set: (Procedure and Description)

New Accessories: (Description)

33" Maple (remaining live trunk) brs. S78°W, dist. 44.2',

scribed T22S R10W S23 MC CSBT

Location and Comments:

20°E

Compass Declination

LOCATION: From Scottsburg,

U.S.F.S.

Agency

USFS Land

Park entrance go West on

Ernest R. Alvarado

Party Chief

Surveyor

Hwy. #38 0.6 mile to

Carol Dickison

Notekeeper

location poster on Maple

Colin Long

Witnesses

North of Hwy. Corner

lies N20°W, dist. approx.

200'. Attention sign at corner site (cap buried

1½' below ground surface). Second location poster


on piece of snag, from which corner lies 1.0' South.

Distances are to side and center of trees at root crown.

K JEM

4/2/82
E. R. Alvarado
Colin Long
Carol Dickison

Ed. Douglas Co. brass cap
1/2' below ground surface

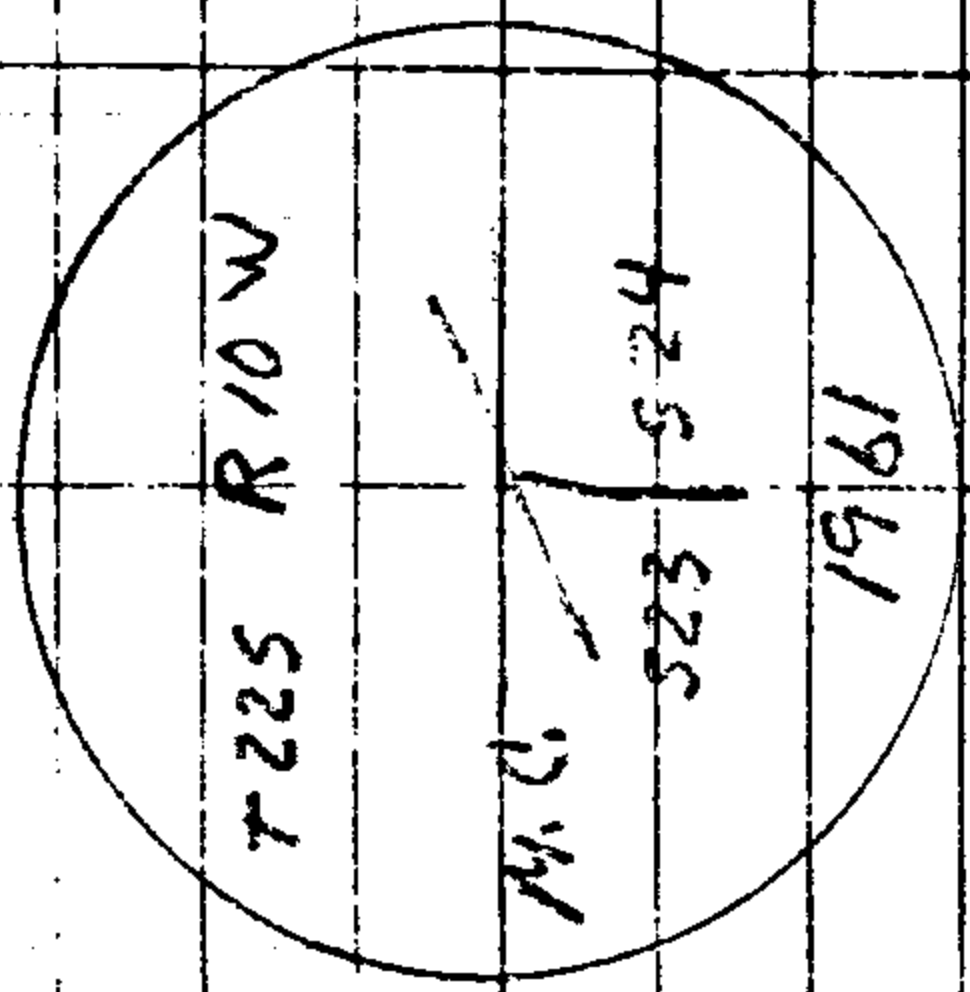

RAW SLOPE
BRNG

VERT
A

SLOPE
DIST

HORIZ
A

TEMP

V
DIST

23/24
Left bank Unipgue River
2
M

M.C.
23/24
Left bank Unipgue River
2
M

Maple BT (triple trunk)
The scribed part of tree
Ed. uprooted, fell
toward river.

33" Maple
Brs. 578°W
Dist. 442'

Scribed (remaining live trunk):
T225 R10W S23 MC C5BT

1

Location: From Scotsburg Park entrance go
west on M Hwy # 38 0.6 miles to location
poster on Maple North of Hwy. Corner lies
N30°W, dist. approx. 200'. Attention sign
at corner site (cap buried 1/2' below ground
surface). Second location poster on
piece of snag, from which corner lies 10' South.

16" Dogwood
Brs. 562°E
Dist. 488'

Healed face

FILED
RECEIVED
JUN 1 1982
COUNTY CLERK
TOWNSHIP CLERK
SHERIFF
CORRECTION OFFICER