

DATE: March 12, 1982

Condition Report Onl

Not Found

Renewed

Unrecorded

Surveyed In

Referenced Out

Previous Renewal #'s _____

Monument(s) Found: (Condition and Source) _____

B.L.M. brass cap, 7" above ground, in good condition,

marked: S21 S28 1/4 T19s R9W 1969.

Accessories Found: (Condition and Source) _____

29" Hemlock, brs. N45 $\frac{1}{2}$ °W, dist. 15 $\frac{1}{4}$ ', scribing visible: 1/4 S21

S.E. B.T. has been destroyed by road construction.

Page 1 of 1

G.S. File No. 61/32-4

#22+

C

Location and Comments:

LOCATION: Go South on
F.S. Rd. #23 approx.
0.7 mile past junction
with B.L.M. Rd. #20-9.1
to Rd. #19-22.2. Then
go to the end (turn
right at fork). Corner
is 40' West of the road.
Location poster on East side of road.
Corner brs. S84°W, distance 77'.

20° East

U.S.F.S.

Ernest R. Williams

(same)

Colin Long

Carol Dickison

Witnesses

Party Chief Land
Notekeeper Surveyor

Agency U.S.F.S.
Compass Declination

OK

S28 CSBL.

New B.L.M.: 12" Hemlock, brs. S90W, dist. 438', marked: 1/4

New Accessories: (Description)

None set

Monument Set: (Procedure and Description)

RENEWAL

1/4 Corner btwn. S. 21 & S. 28
T195 R19W

2

Photo # M 779-9, Timber

29" Hemlock

Brs N 4 1/2 W

1

Dist. 15 1/4

2

scribing visible

M

1/4 S 21

11"


N

12 MAR 1968

Colin Co

Carol Dic

A

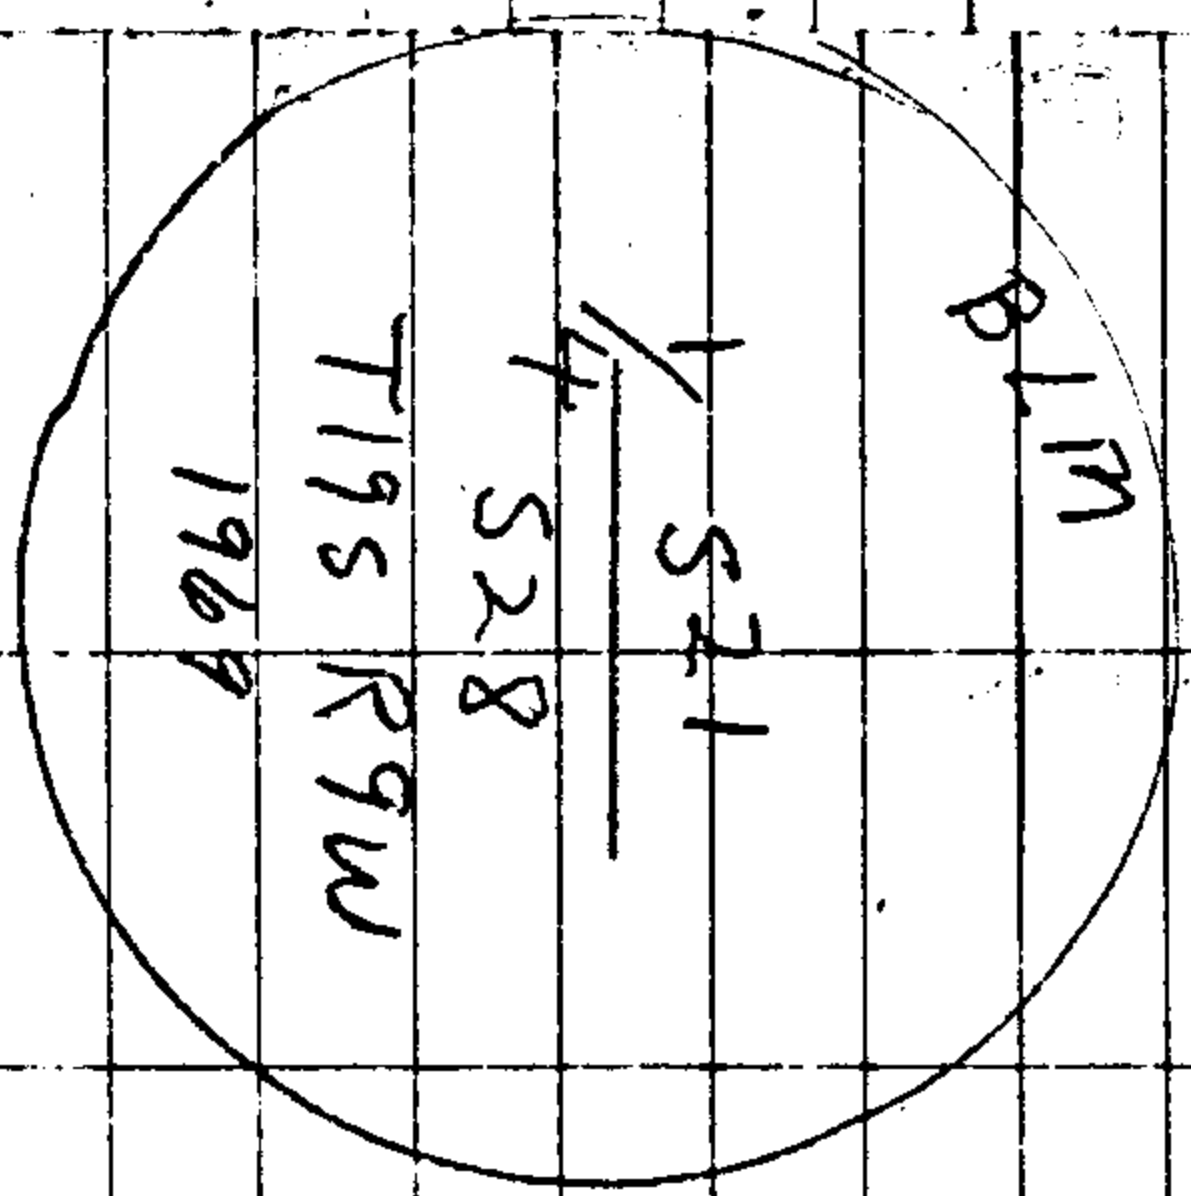

11"

NEW BT

12" Hemlock

Brs S 90 W

Dist. 43 1/8

marked 1/4 S 28 CSB

A

A

SE BT

ROAD

TO EXIST ROAD BLM # 19-282. Then
Go to the end of ^(turn right at fork) corner is 40 FT
West of the Road.

160, on ^{south} E.S. Road # 23 ^{APPROX 0.7 mi. past} junction of BLM RD 20-91

Location Post on East side
of road. corner brs. S 84 W, Dist.
77 FT.