


T305R2W

DATE: APRIL 8, 1982

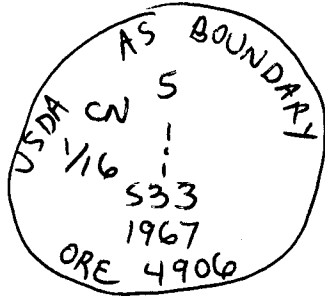

Condition Report Only  
 Not Found  
 Renewed  
 Unrecorded  
 Surveyed In  
 Referenced Out

Previous Renewal #'s 87

Monument(s) Found: (Condition and Source)

2 1/2" BRASS CAP, FLUSH WITH AND SET IN 6"

DIAMETER CONCRETE COLUMN, WHICH PROJECTS

3" ABOVE 2 FT. DIAMETER CONCRETED MOUND

OF STONE. SET BY BRUCE SHANER, P.E. # 4906

IN 1967. BRASS CAP MARKED AS ABOVE.

Accessories Found: (Condition and Source)

BTS MARKED BY SHANER IN 1967:

36" D. FIR, N22°E, 118° FT. WITH HEALED BLAZE.

26" D. FIR, N61 1/2° W, 82° FT. WITH HEALED BLAZE.

RENEWAL

Monument Set: (Procedure and Description) \_\_\_\_\_

New Accessories: (Description) \_\_\_\_\_

SET 6' STEEL FENCE POST WITH USFS SIGN #54-9

2 FT. SOUTH OF CORNER.

Location and Comments:

20°E

Compass Declination

CORNER IS 40 FT.

USFS

Agency

~~S~~ 520°W OF  $\phi$  HWY

~~A~~ JIM LANDAUM

Party Chief

Notekeeper

227 AND  $\pm$  175 FT. OF

LEONARD HERZSTEIN Witnesses

SOUTH UMPQUA BRIDGE.

OK *[Signature]*