


T32S R3W

DATE: MAY 3 1982

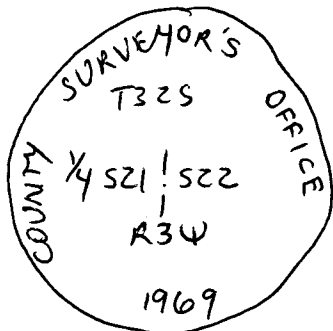

Condition Report Only  
 Not Found  
 Renewed  
 Unrecorded  
 Surveyed In  
 Referenced Out

Previous Renewal #'s 66; M49-69; M56-20

Monument(s) Found: (Condition and Source) \_\_\_\_\_

1" I.P., WITH BRASS CAP MARKED AS ABOVE, FIRMLY SET, PROJECTING 16" ABOVE GROUND, LEANING SLIGHTLY SE. SET BY JOHN POWELL, DOUGLAS COUNTY SURVEYOR'S OFFICE, IN 1969.

Accessories Found: (Condition and Source) ORIGINAL BTS:

A 46" D. FIR, N55°E, 39½ FT. (REC. 40¾ FT.) WITH HEAVED BLAZE

A 28" D. FIR STUMP, N14°W, 48½ FT TO FACE, WITH OLD AX MARKS VISIBLE ON DECAYED BLAZE.

AND BT MARKED BY POWELL IN 1969

A 10" MADRONE, N3°E, 40½ FT. (REC. 40½ FT.),

#214X

WITH SCRIBE MARKS "1/4 SZZ CS BT" VISIBLE  
ON PARTLY HEALED BLAZE.

RENEWAL

Monument Set: (Procedure and Description) \_\_\_\_\_

New Accessories: (Description) \_\_\_\_\_

I MARK NEW BT: ~~8~~

A 7" P. PINE, N77°W, 238 FT., SCRIBED  
"1/4 S21 CS BT" ON DOUBLE BLAZE.

Location and Comments:

CORNER LIES ON  
STEEP S.E. SLOPE  
ABOUT 150 FT.  
WEST OF USFS  
RD# 3231.

19'4"E  
U.S.F.S.  
LEONARD HERTSTEIN  
JIM LANDRUM  
JIM HAMILTON

Compass Declination  
Agency  
Party Chief  
Notekeeper  
Witnesses

OK  
JEM